


T. 2 N., R. 2 W., W.M.

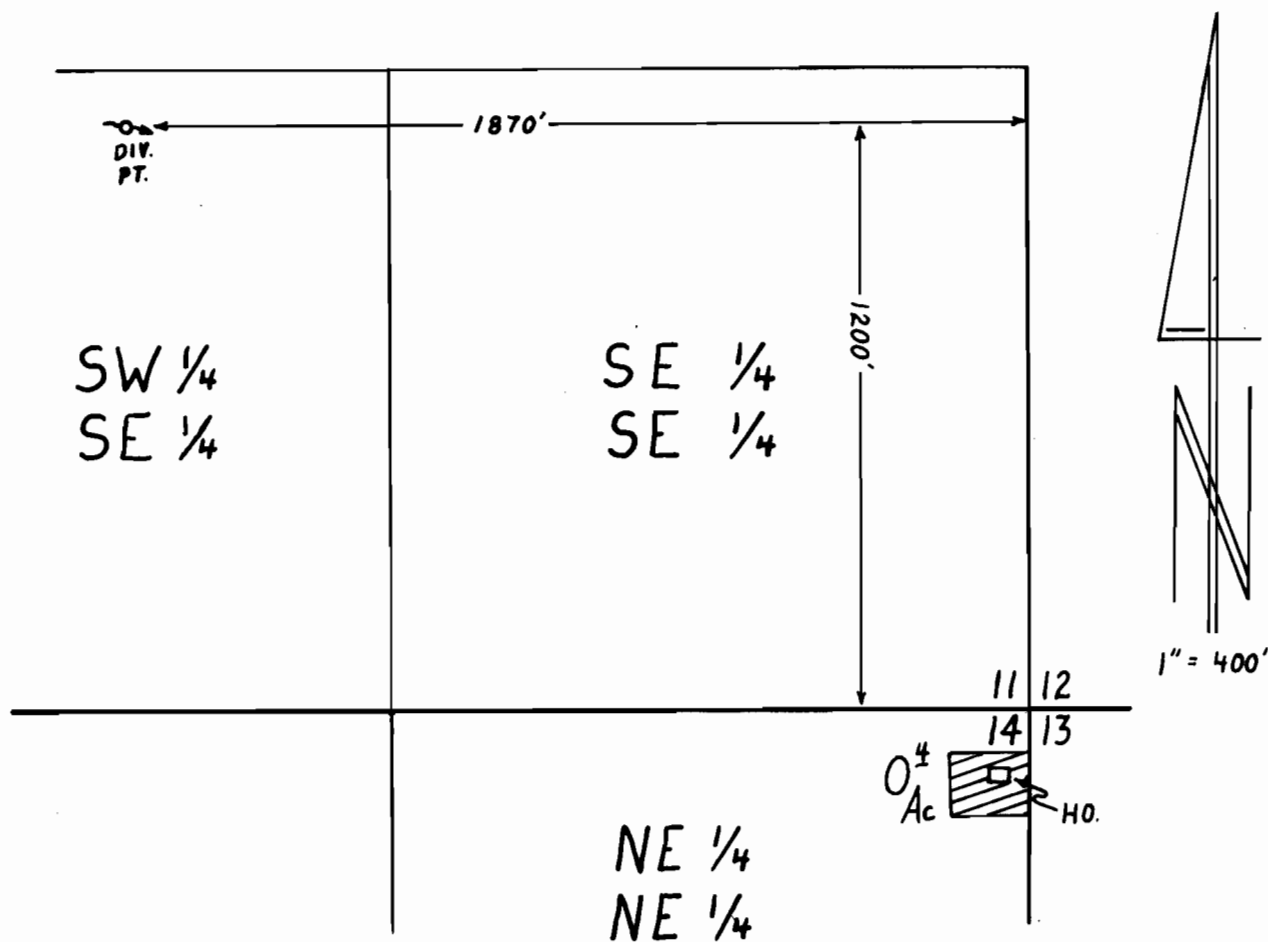

FINAL PROOF SURVEY

UNDER

Application No. 58782 Permit No. 44814
IN NAME OF

CHESTER W. KORPOWSKI

Surveyed August 7, 1991, by R.W. Klassen