


T. 27 S., R. 13 W., W.M.

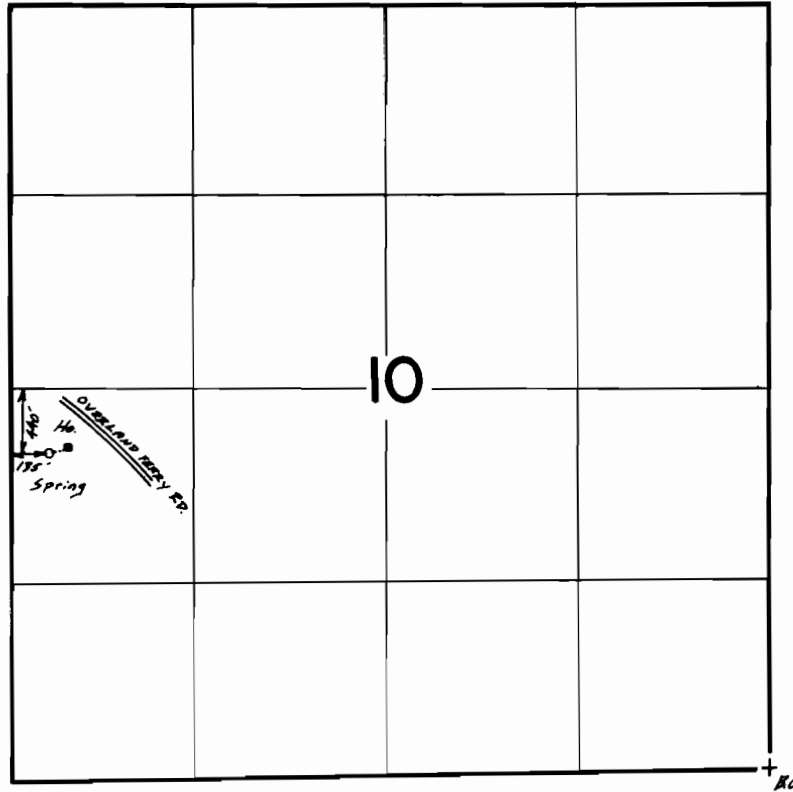

Scale 1"=1320'



**FINAL PROOF SURVEY
UNDER**

Application No. 60212. Permit No. 46097....
IN NAME OF

Benjamin F. & Kelly M. Mahoney

Surveyed June 17, 1992, by B.S. James