


T. 32 S., R. 2 E., W.M.

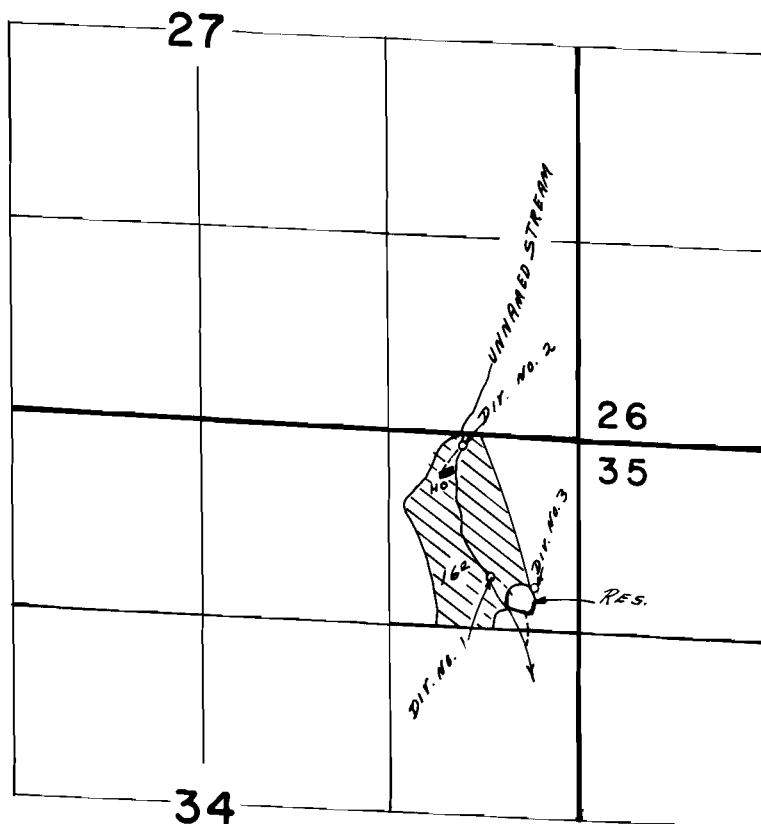

Dir. No. 1: 900' S, 600' W.;

Dir. No. 2: 30' S, 800' W ;

Dir. No. 3: 1000' S, 300' W ;

FROM NE COR. SEC. 34

Scale: 1" = 1320'

FINAL PROOF SURVEY

UNDER

R-61670

R-8400

Application No. 61671 Permit No. 46677

IN NAME OF

KENNETH A. LEE

Surveyed JUL. 22, 1986, by B. S. JAMES