


T. 38 S., R. 25 E., W.M.

~~64003~~
46003
68286

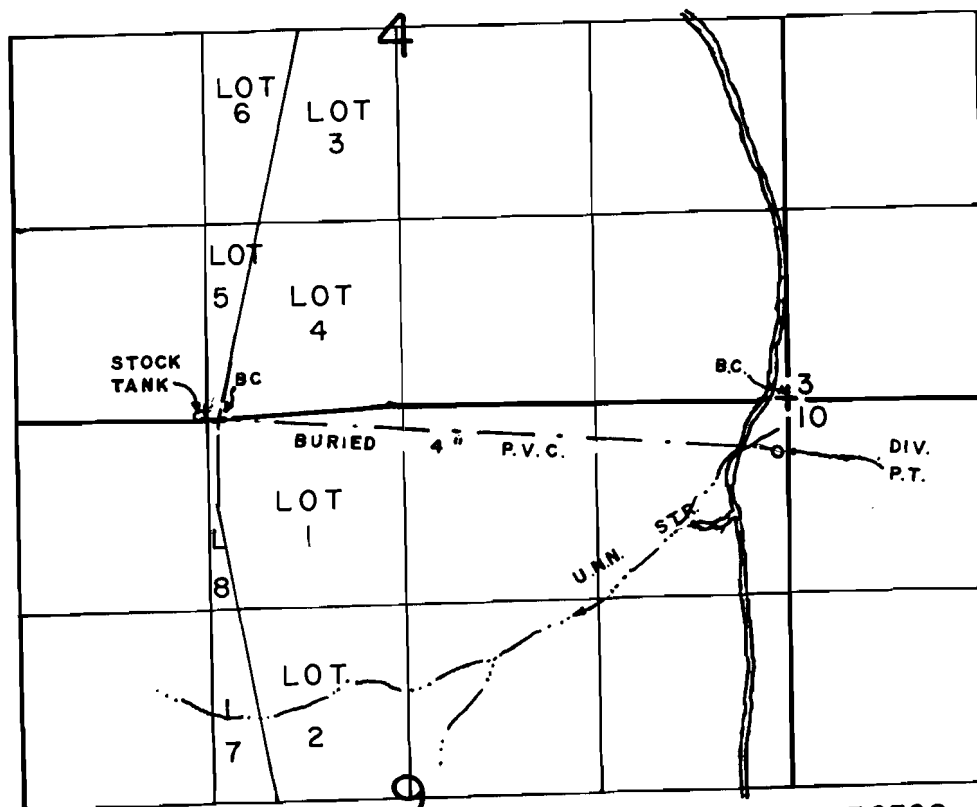

DIV. PT. LOC: 370'S & 70'W FROM NE COR. OF SEC 9.

SCALE: 1" = 1320'

FINAL PROOF SURVEY

UNDER

Application No. 61920 Permit No. 46003
IN NAME OF

TRAVELERS INS. CO.

Surveyed JULY 21, 1992, by B.W.BISHOP