


T. 2 S., R. 7 E., W.M.

SECTION 33

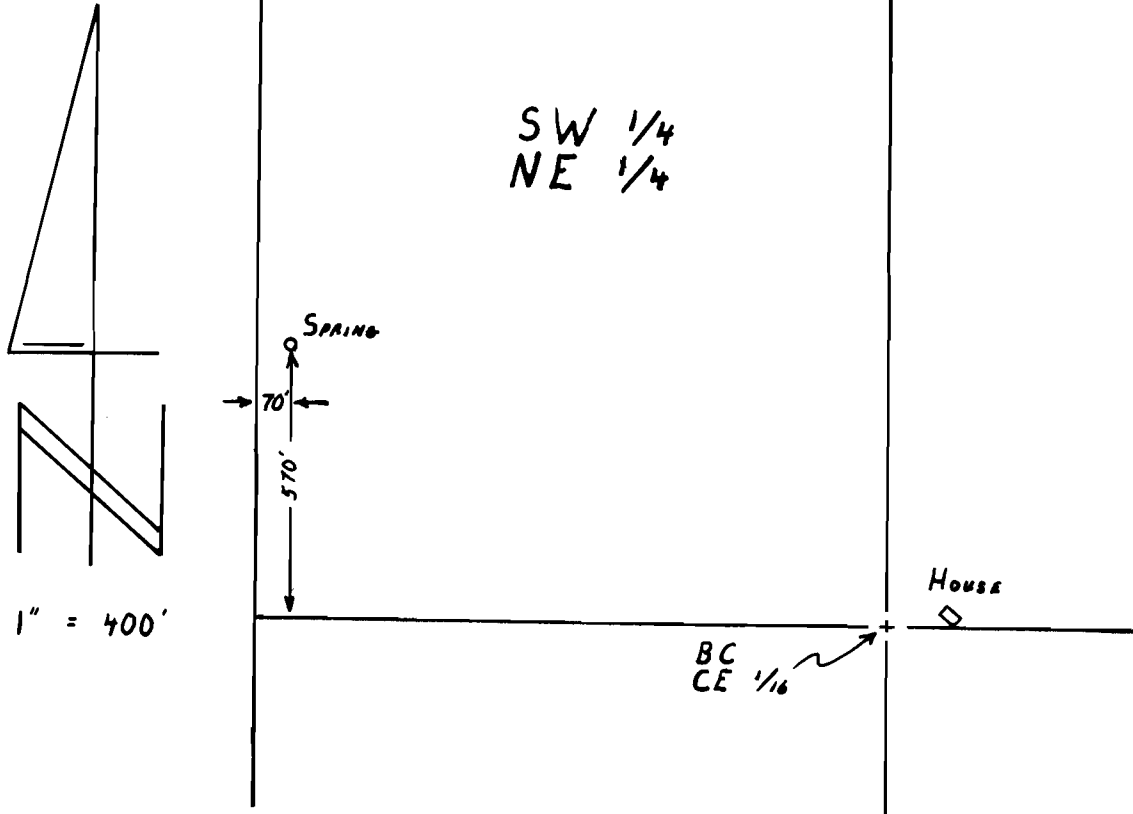

FINAL PROOF SURVEY

UNDER

Application No. 63008 Permit No. 46975

IN NAME OF

THOMAS ADRIAN CHANCE

Surveyed JULY 29, 1991, by R.W. KLASSEN