


T. 27 S., R. 3 W., W. M.

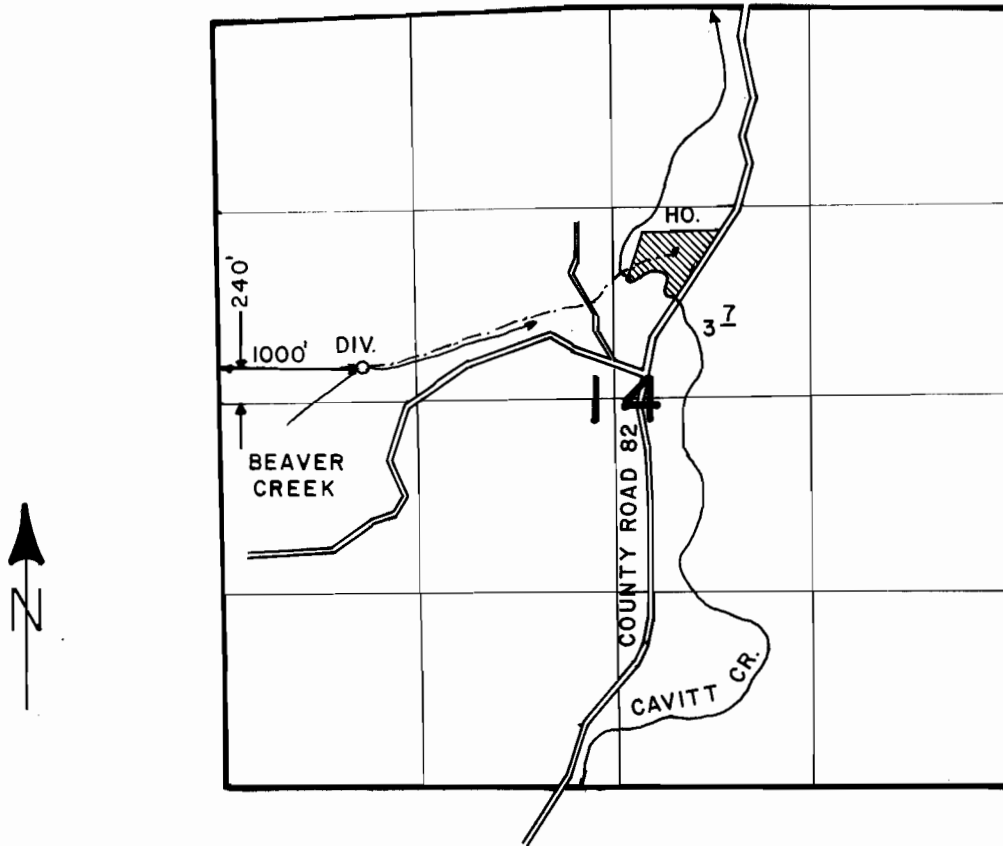

SCALE: 4" = 1 MILE

**FINAL PROOF SURVEY**  
UNDER

68207                      48973  
Application No. 64773    Permit No. 47348

IN NAME OF

..... **RONALD K. BALDWIN** .....

Surveyed APR. 5..... 1988., by J.M. SCHMORDE.