


COLUMBIA COUNTY

BEEN PREPARED FOR ASSESSMENT PURPOSES ONLY  
SCALE = 400' Current Revision Date: 4 / 12 / 91

SEE MAP 4 2 6

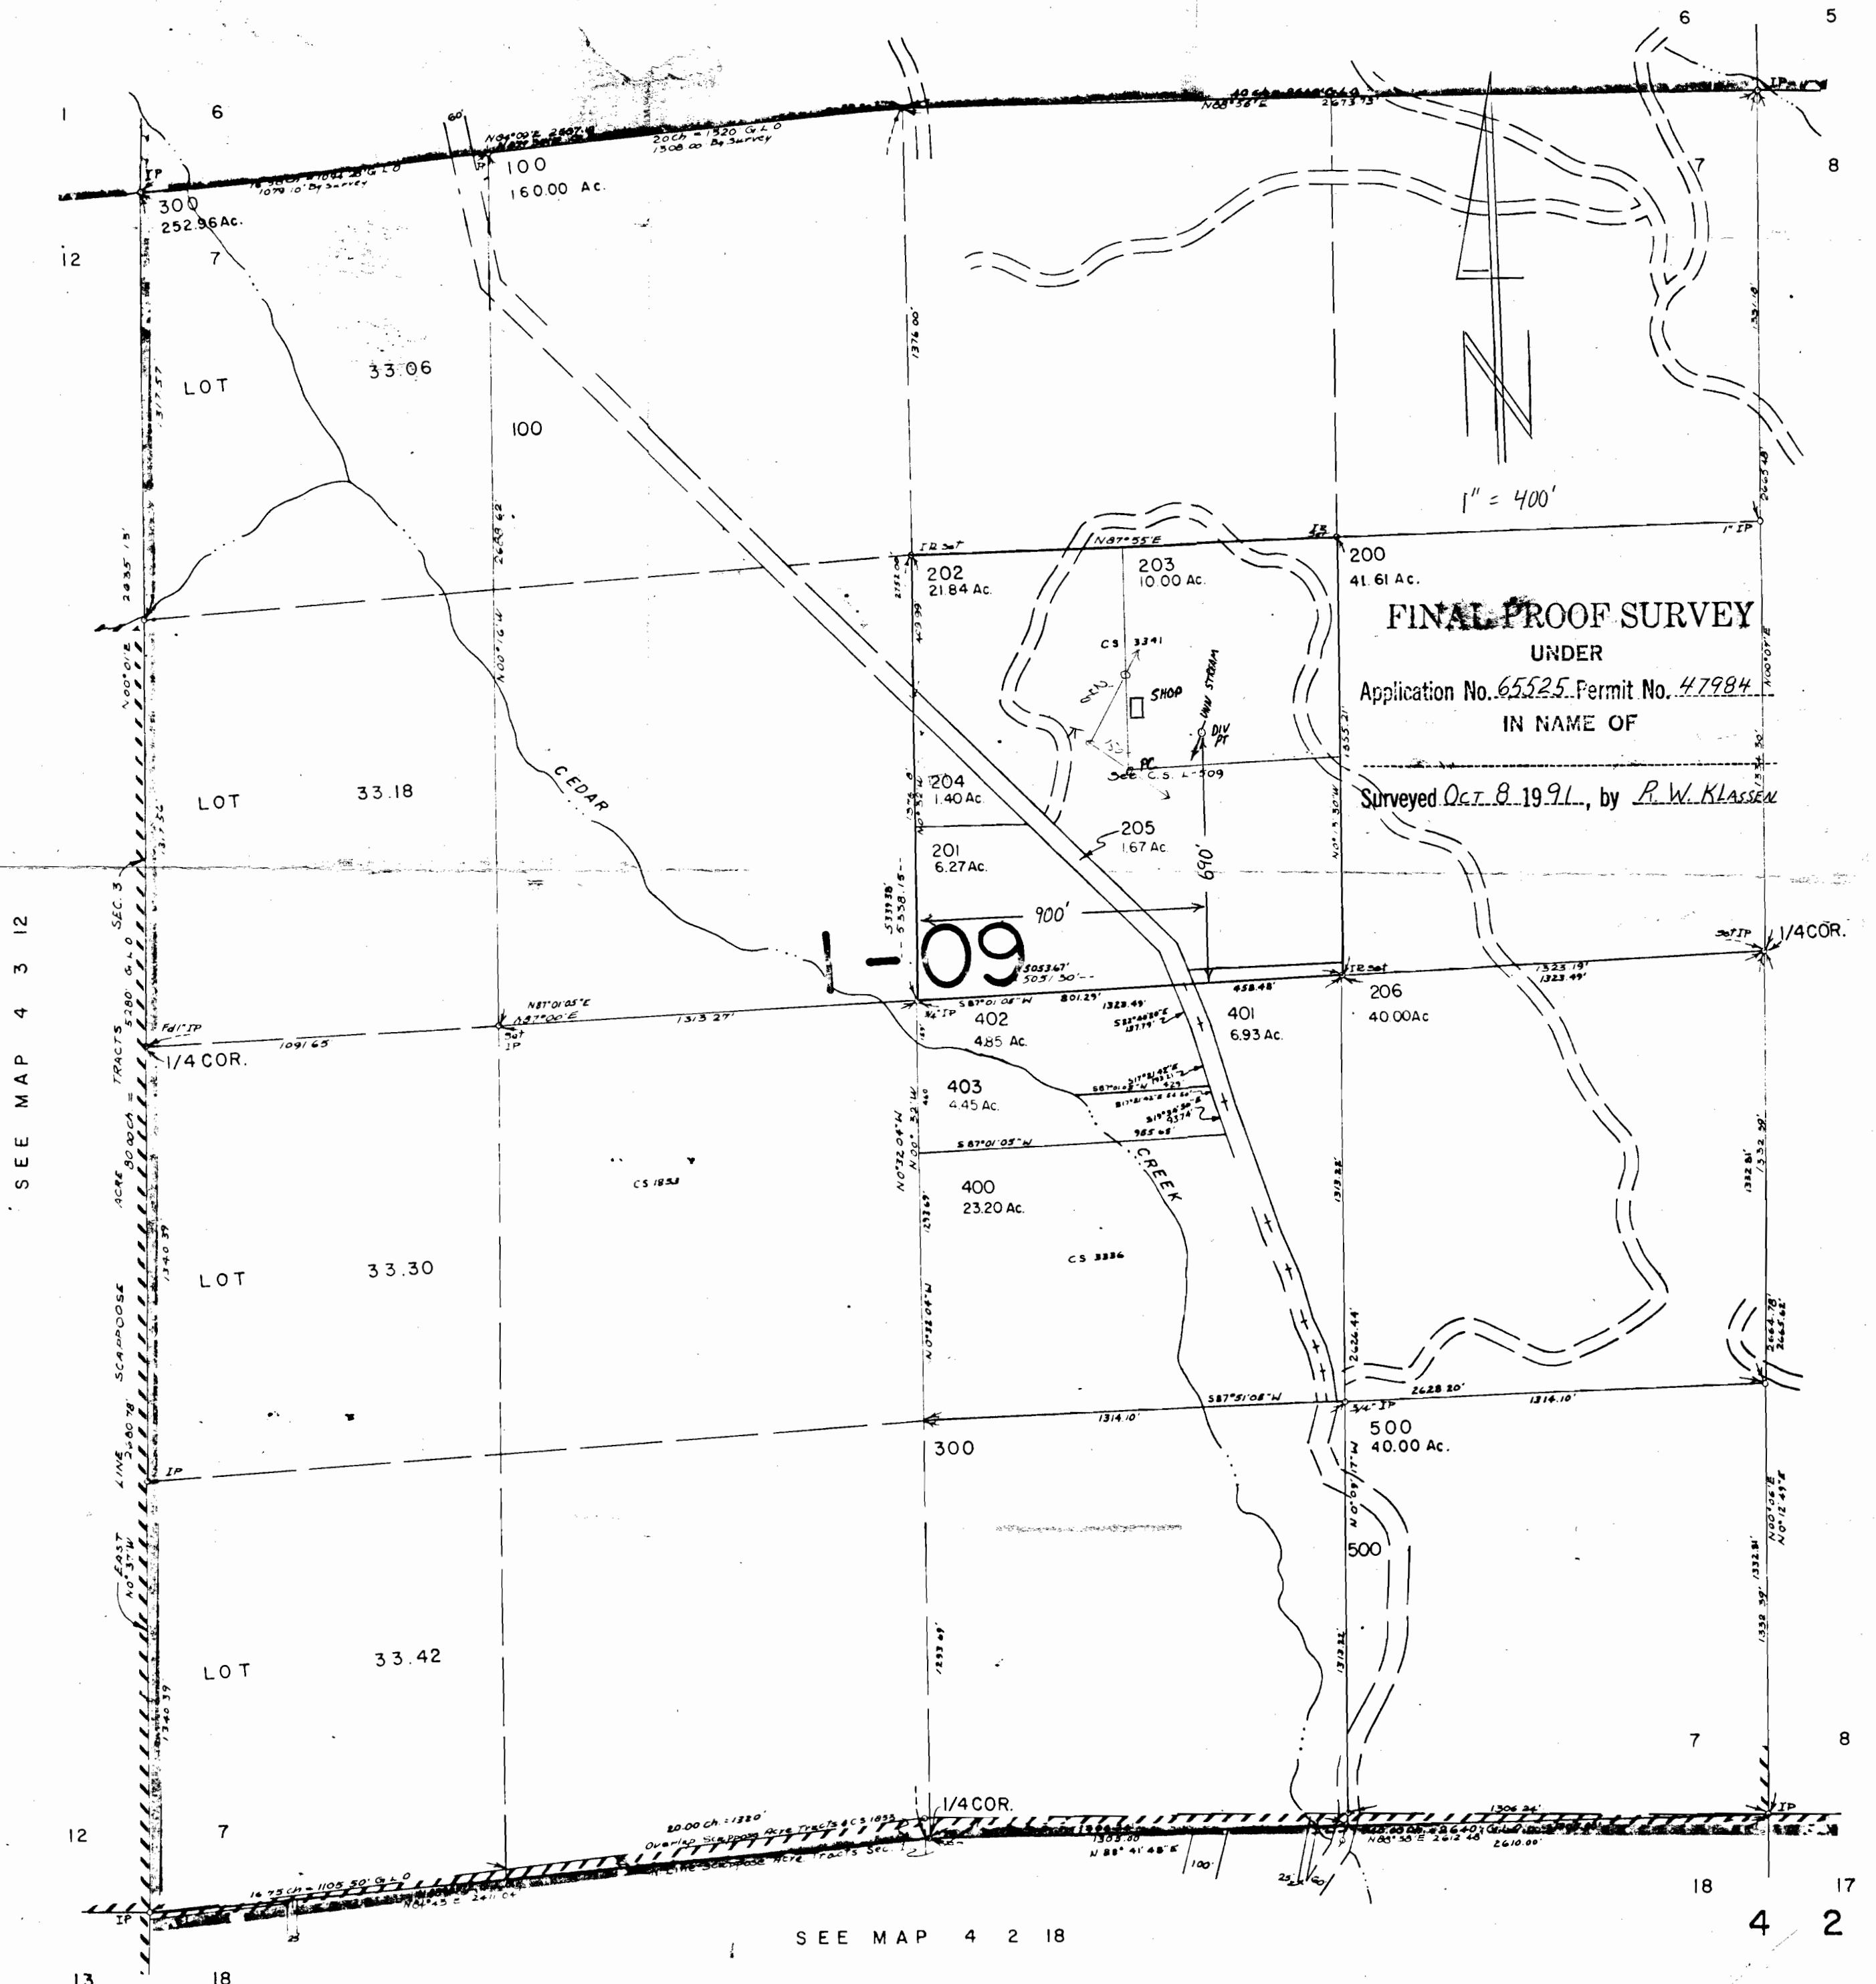

**FINAL PROOF SURVEY**  
 UNDER  
 Application No. 65525 Permit No. 47984  
 IN NAME OF  
 Surveyed Oct. 8, 1991, by P. W. KLASSEN

SEE MAP 4 3 12

SEE MAP 4 2 8

SEE MAP 4 2 18

F.A.D. 3-10-73