


T 18S, R 20E, Sec 12, NW 1/4 NE 1/4

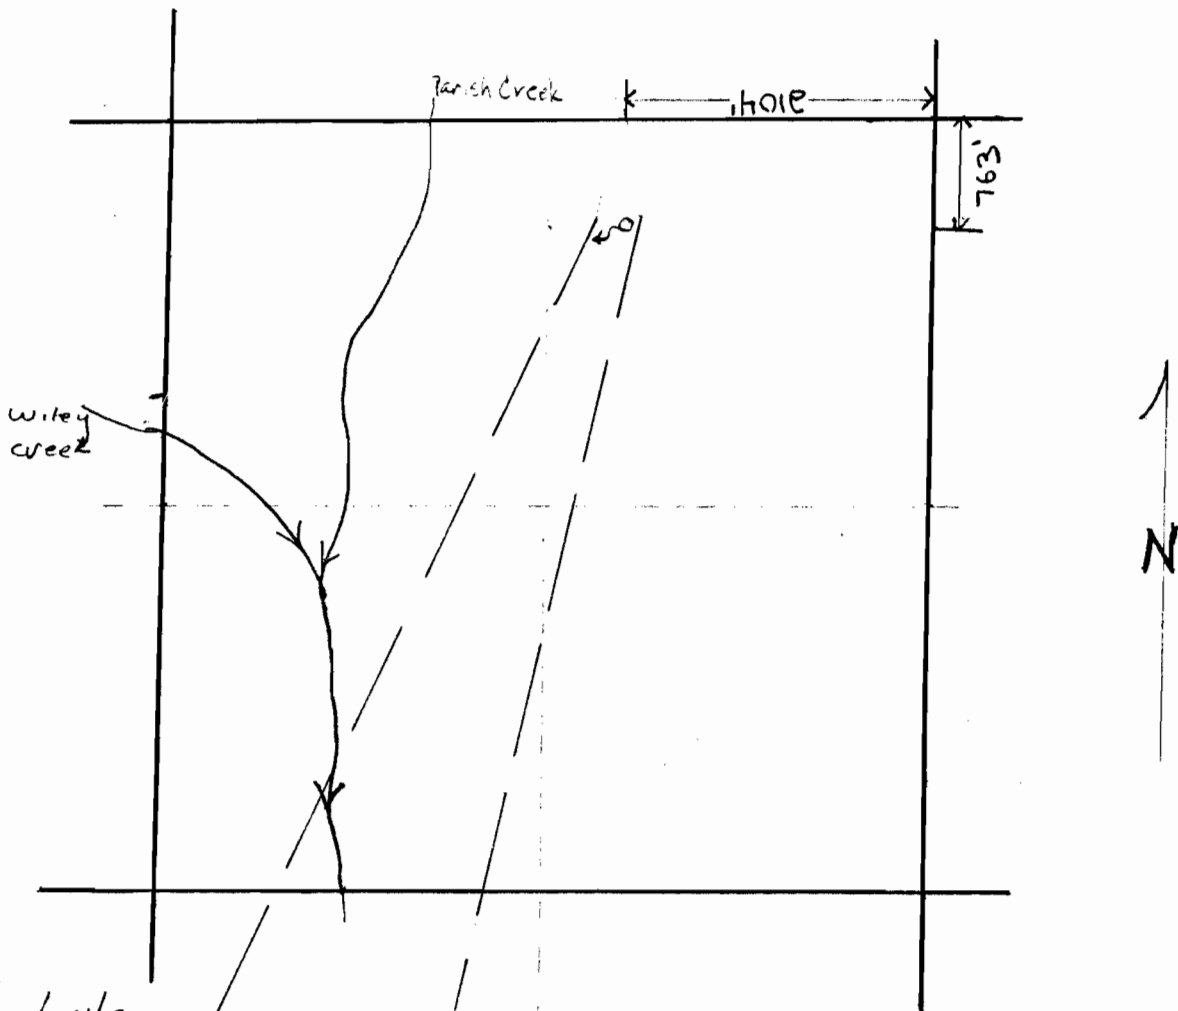

Scale: 4" = 1 mile

Aspen Spring

SEP 19 1983
WATER RESOURCES DEPT.
SALEM, OREGON

Scale 1 inch = 40 feet



Application No. 66347
Permit No. 49532