


Section 34 T.16 S. R.6 W.W.M.

LANE COUNTY

1" = 400'

FOR ASSESSMENT
AND TAXATION
USE ONLY

16 06 34
6-23-78

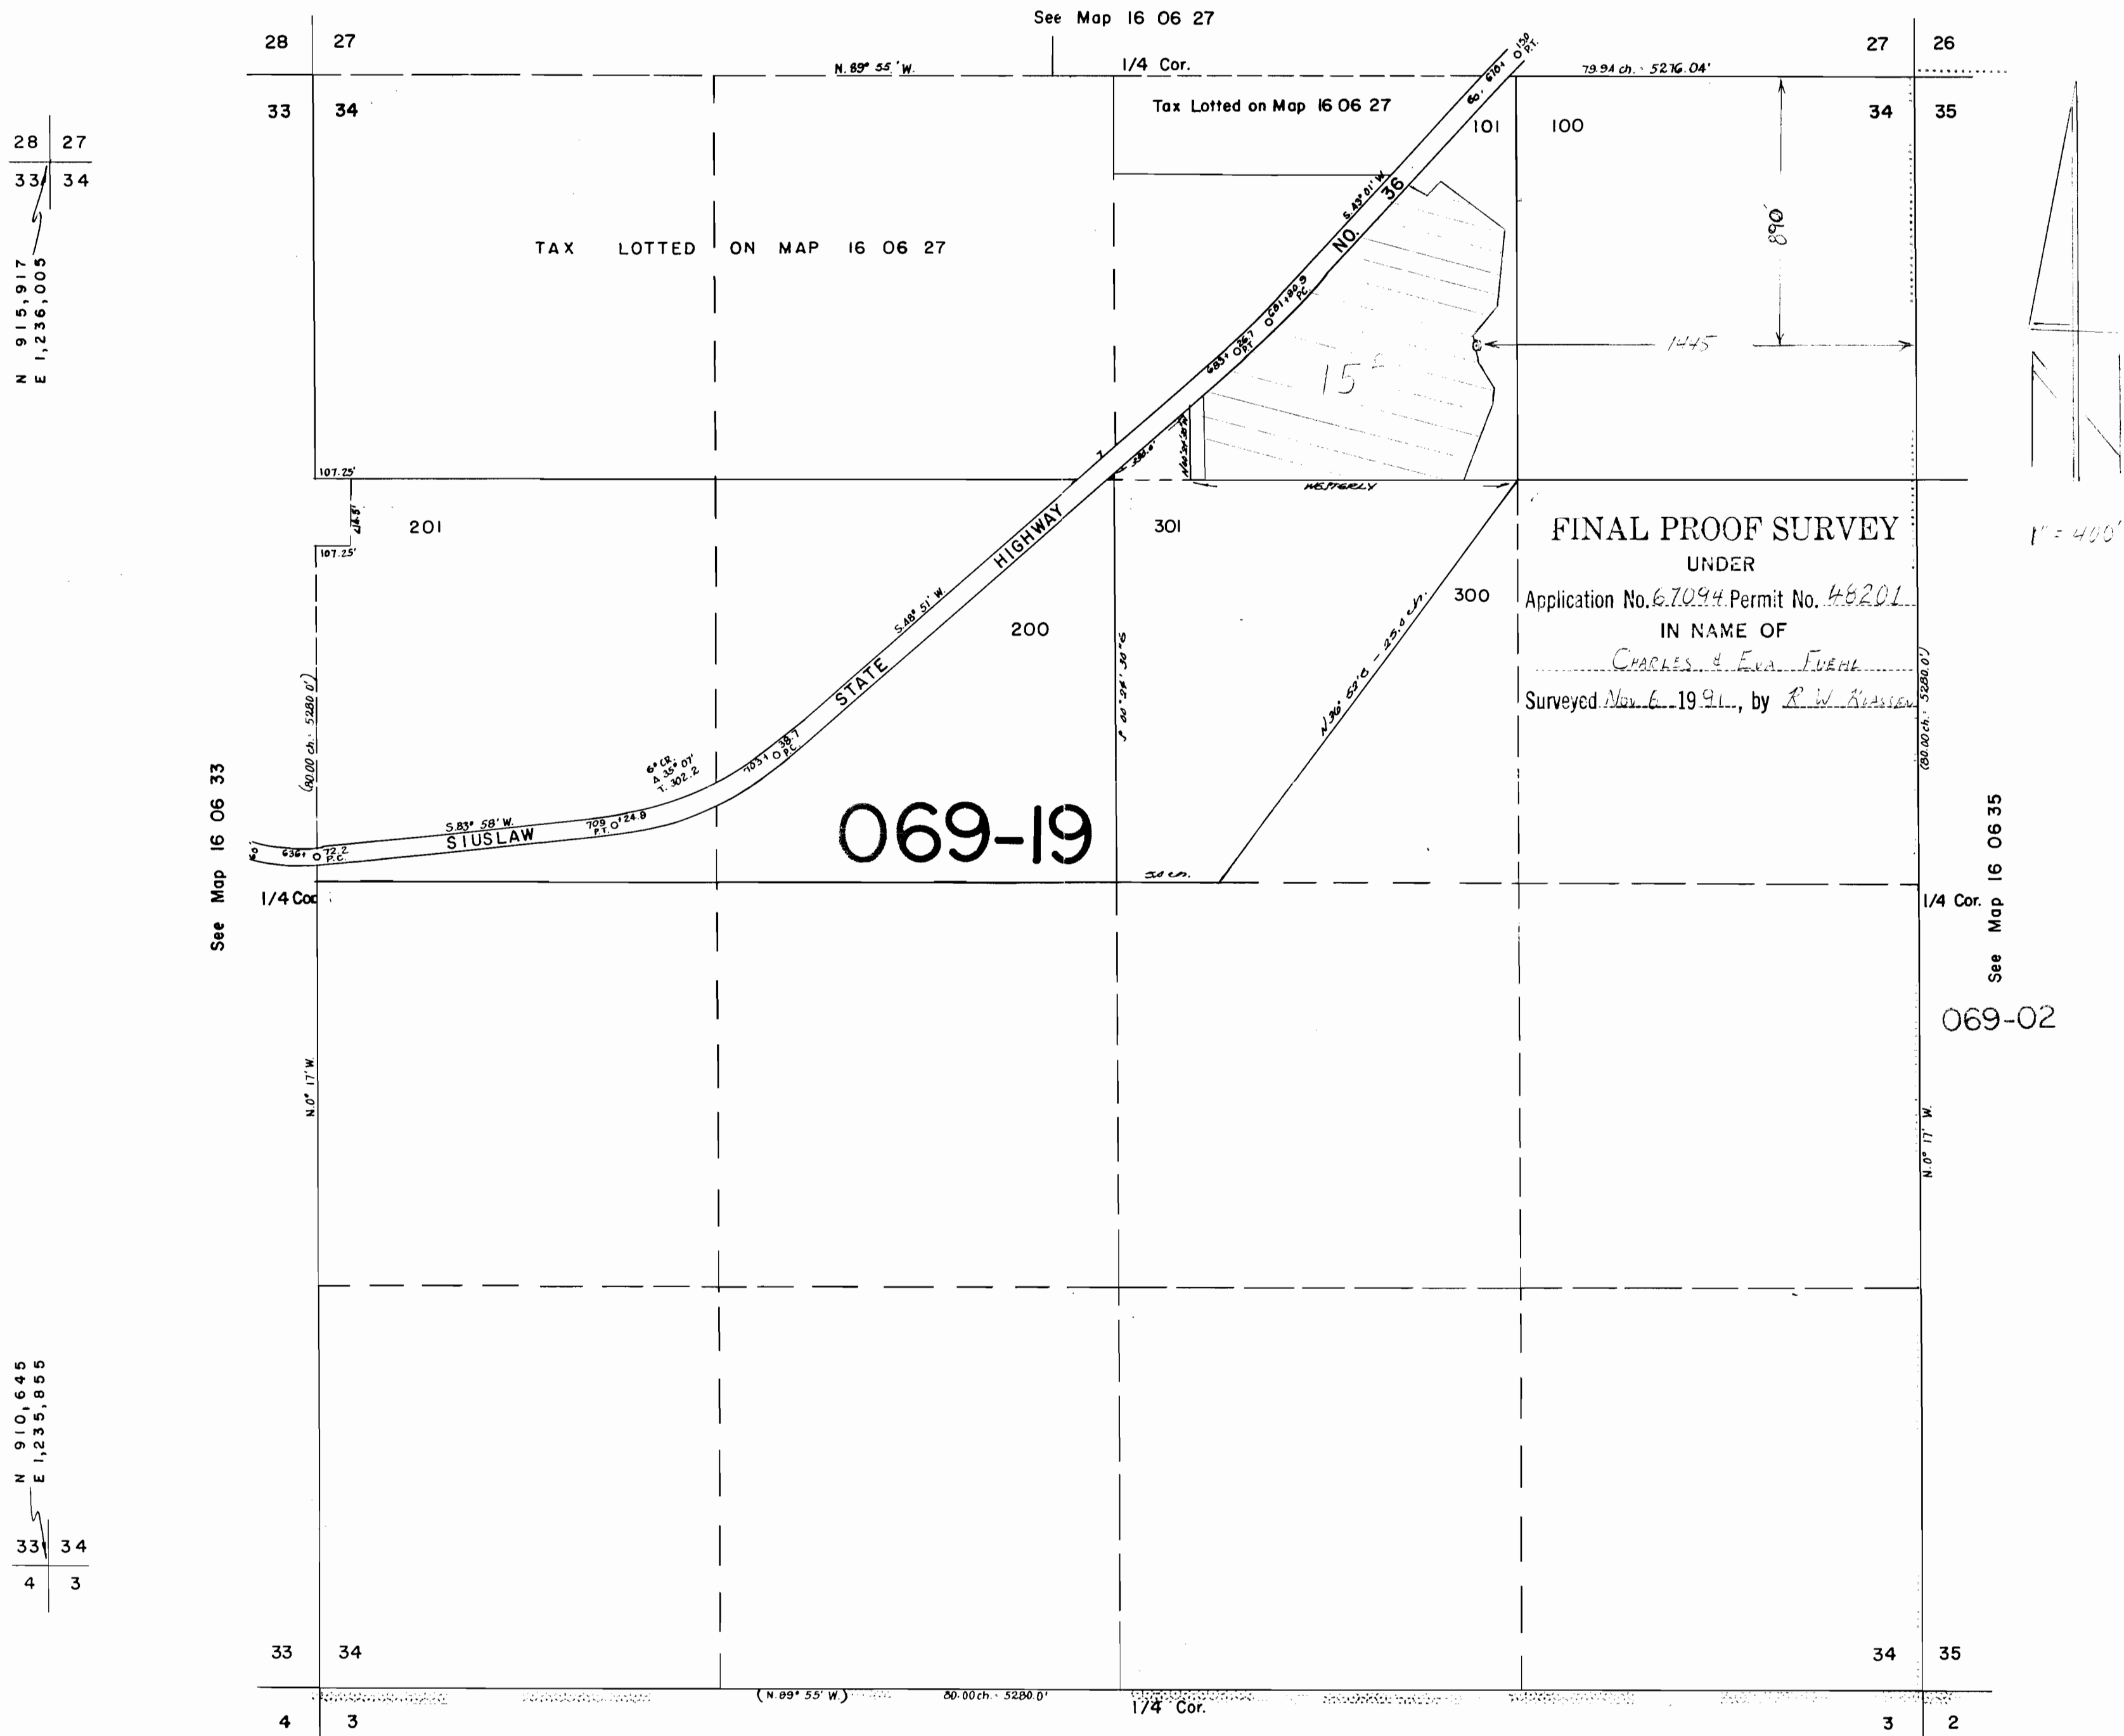

028-12

See Map 17 06 03