


COLUMBIA COUNTY

THIS MAP HAS BEEN PREPARED FOR ASSESSMENT PURPOSES ONLY

Scale: 1" = 400' Current Revision Date: 05/21/86

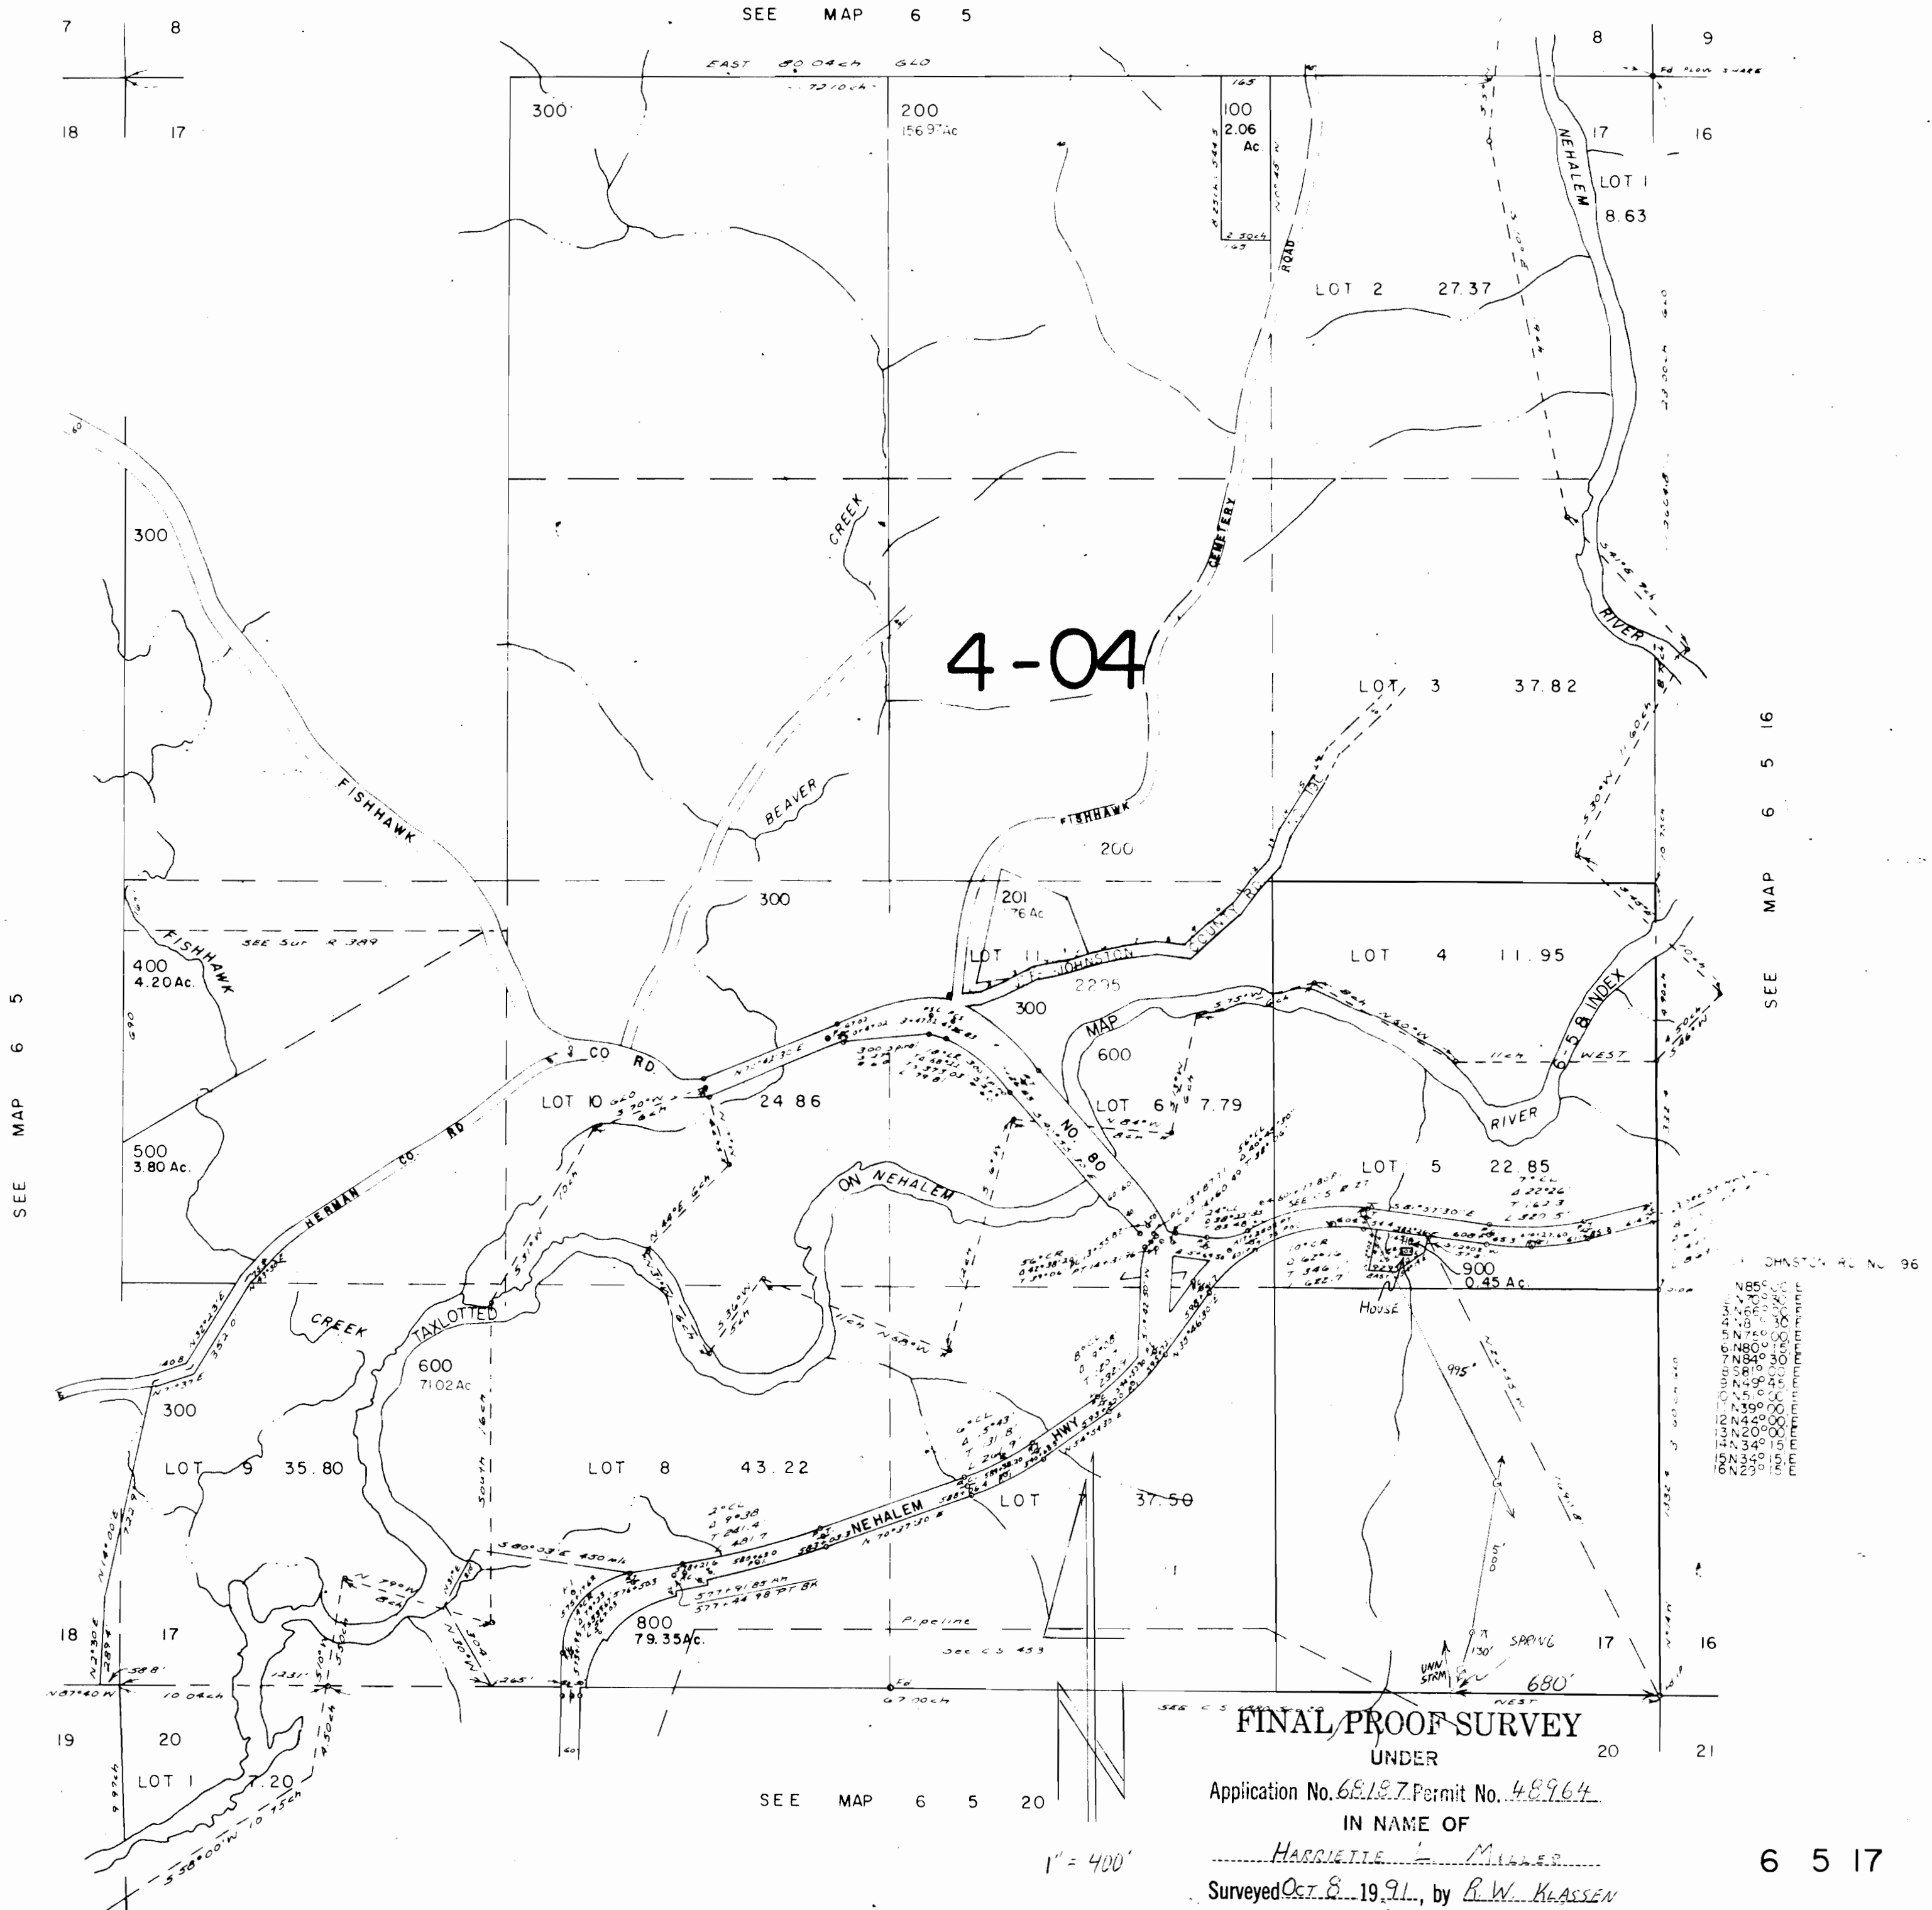

FINAL PROOF SURVEY UNDER

Application No. 68187 Permit No. 48964

IN NAME OF

HARRIETTE L. MILLER

Surveyed Oct. 8, 1991, by B.W. KLASSEN