


T. 19 S., R. 47 E., W.M.

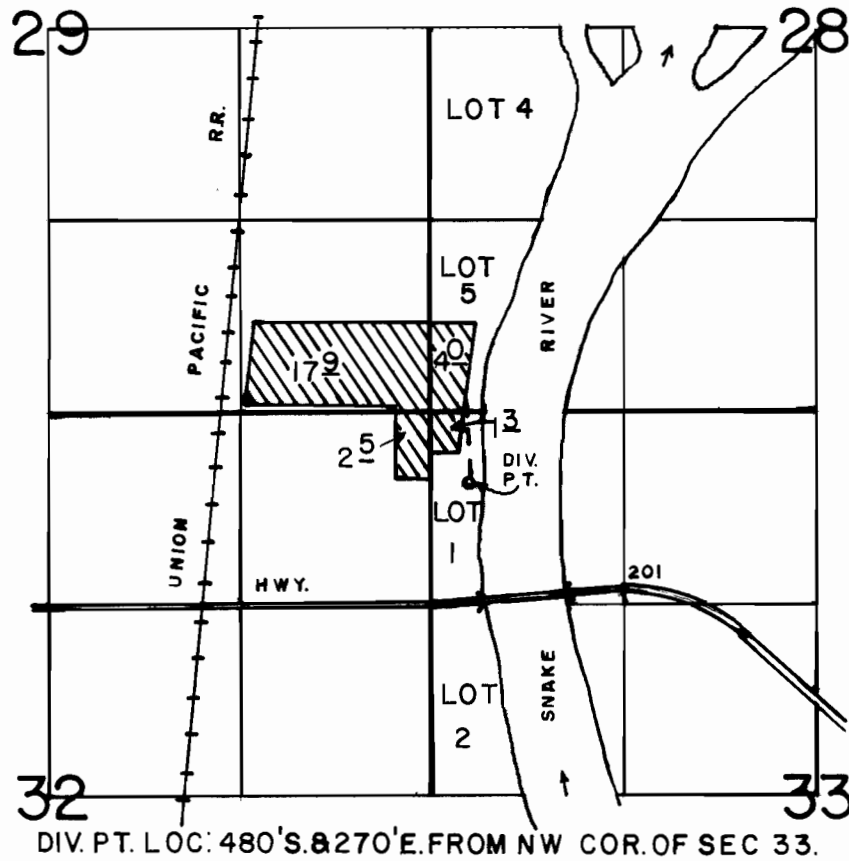

SCALE: 1" = 1320'

FINAL PROOF SURVEY

UNDER

Application No. 68683 Permit No. 49673

IN NAME OF

MALHEUR COUNTY HOUSING AUTHORITY

Surveyed DEC 4, 1990, by K. KEMP