

See Map 20 03 10

FINAL PROOF SURVEY


UNDER

Application No. 69120 Permit No. 50367

IN NAME OF

Surveyed Nov 4 19 91, by R. W. Kline

SEE FINAL PROOF MAP FOR 36008 DIV. PT. # 3 FOR THE LOCATION OF DIV. PT. OF THIS PERMIT

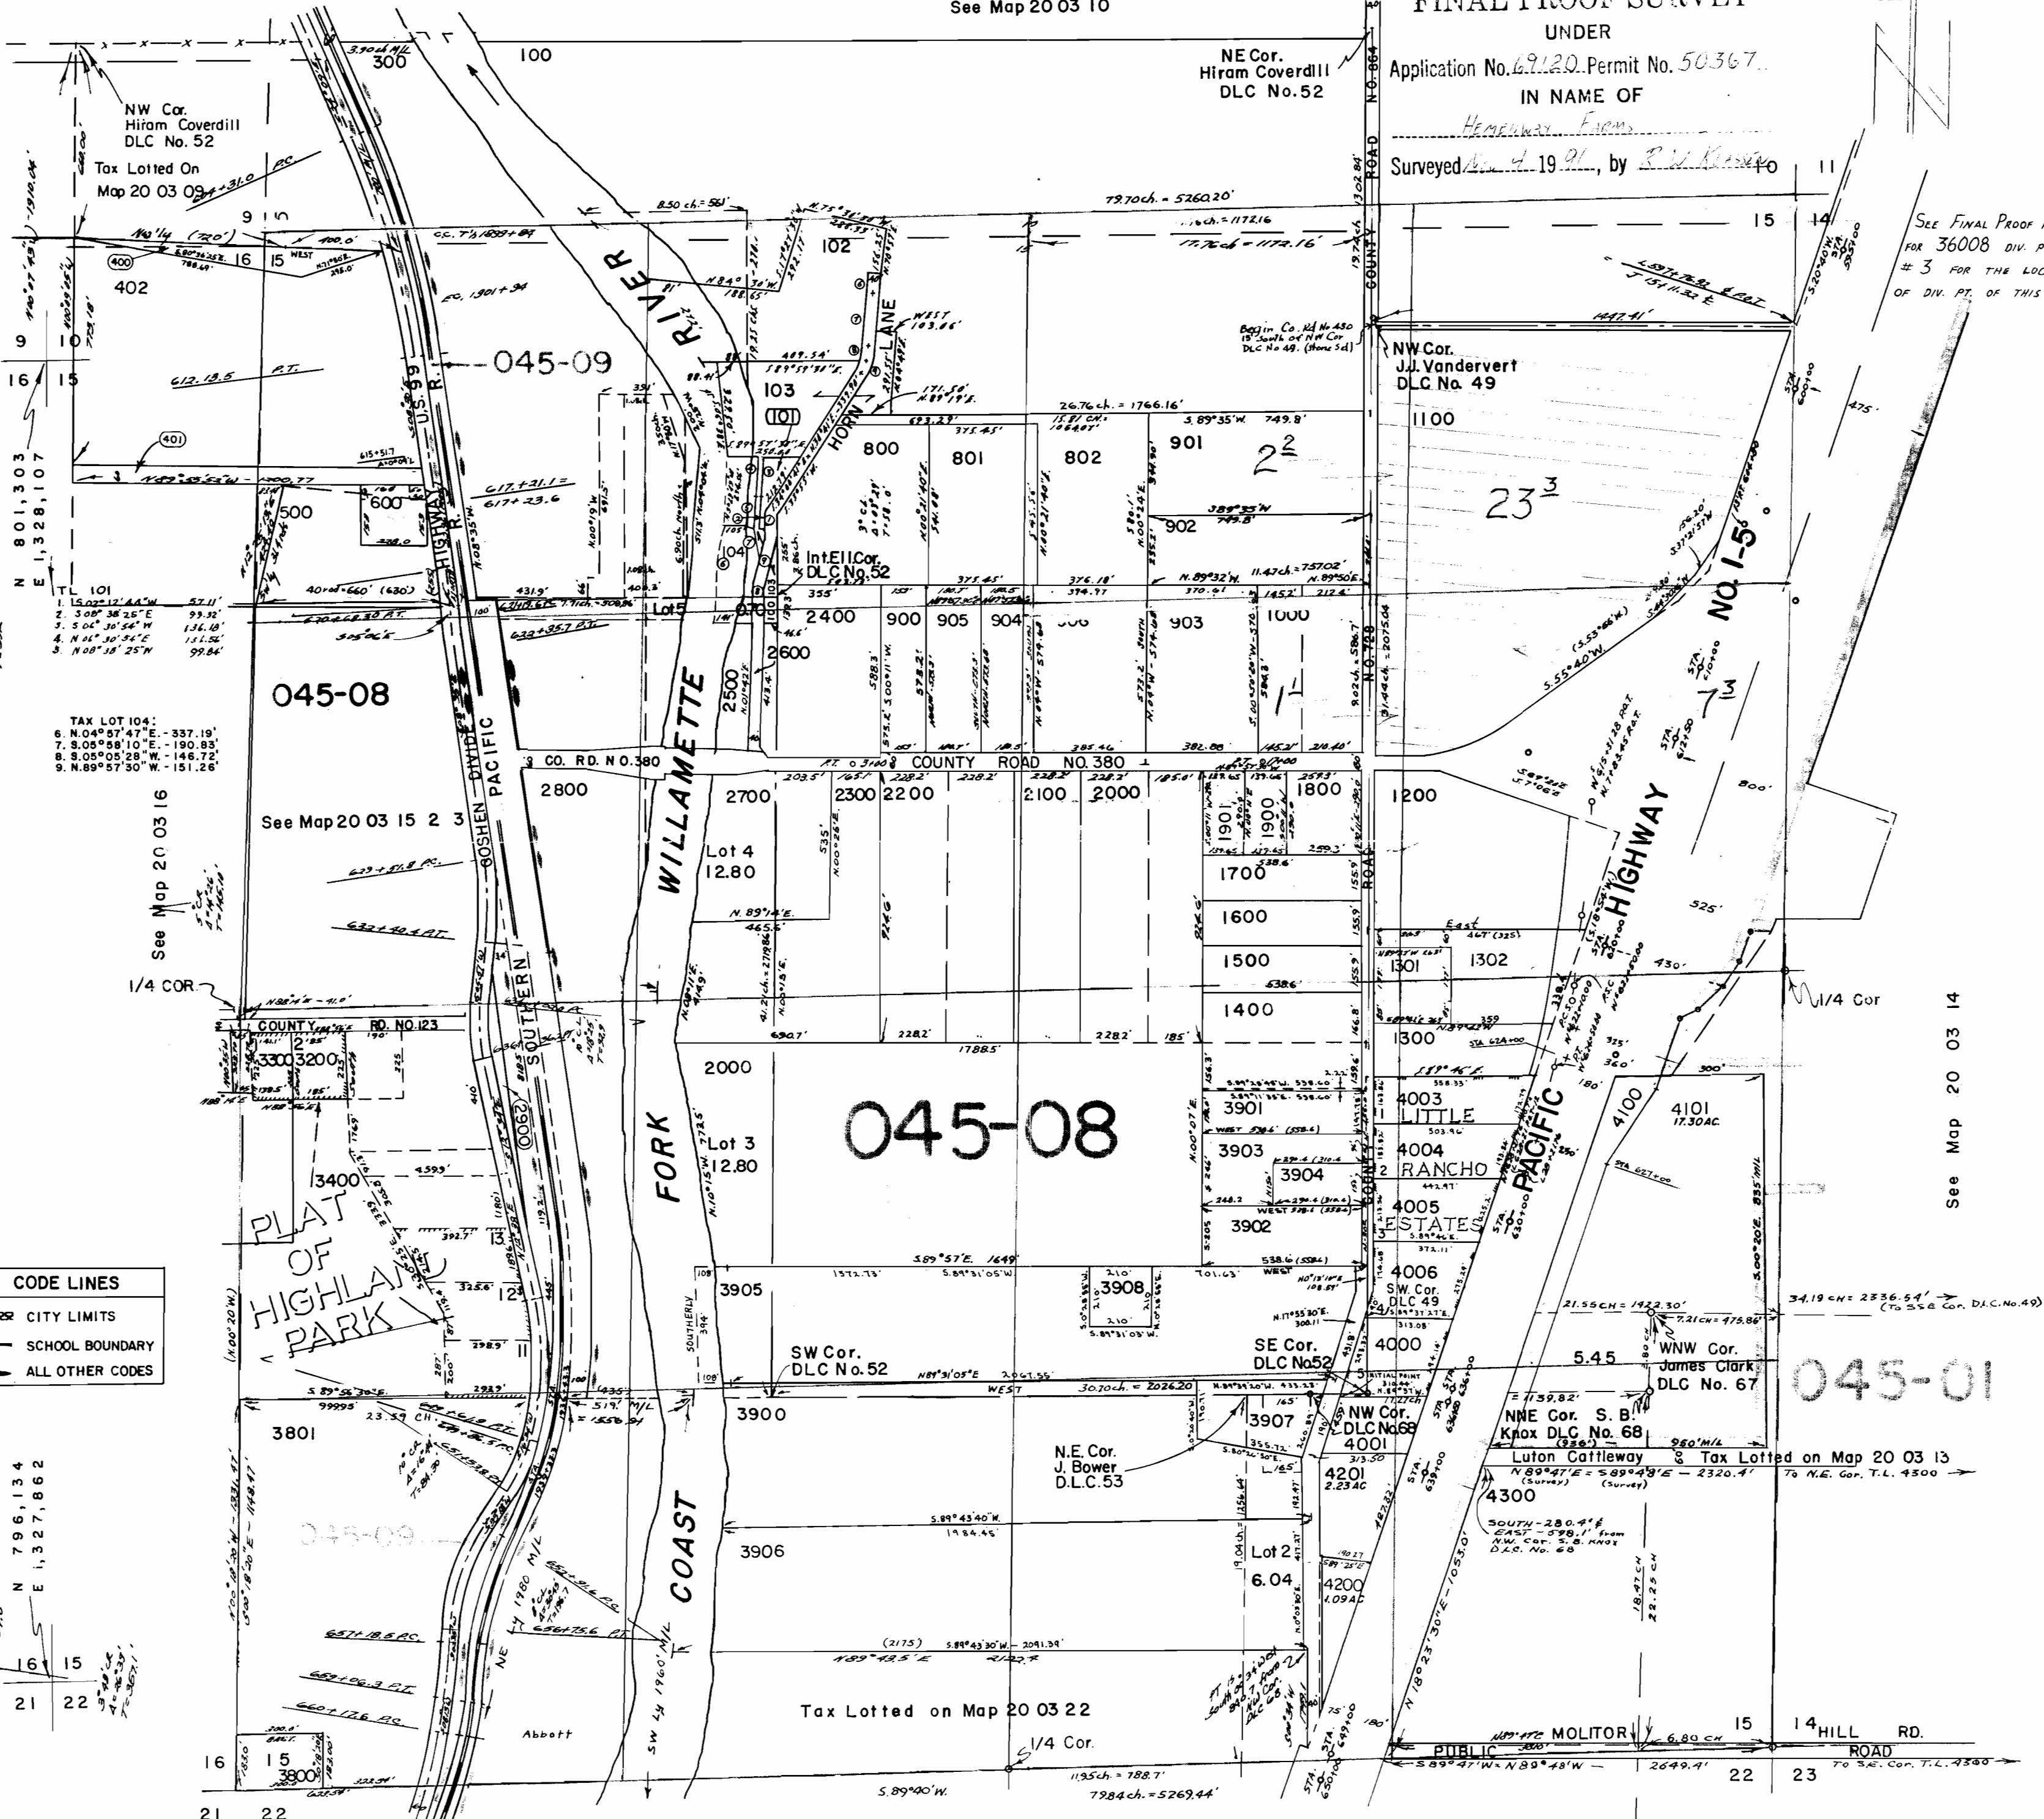

NW Cor. Hiram Coverdill DLC No. 52
Tax Lotted On Map 20 03 09

NE Cor. Hiram Coverdill DLC No. 52

NW Cor. J.J. Vandervert DLC No. 49

045-08

045-08

045-01

- TAX LOT 104:
- 1. S. 04° 17' 44" W. 57.11'
 - 2. S. 08° 38' 25" E. 99.32'
 - 3. S. 06° 30' 56" W. 136.18'
 - 4. N. 81° 30' 34" E. 131.56'
 - 5. N. 08° 18' 25" W. 99.84'

CODE LINES	
	CITY LIMITS
	SCHOOL BOUNDARY
	ALL OTHER CODES

N 796.134
E 1,327.862


See Map 20 03 22

See Map 20 03 14

See Map 20 03 16

See Map 20 03 15 2 3

16 15
21 22

21 22

15 14
22 23

15 14
22 23