

FINAL PROOF SURVEY MAP
 IN THE NAME OF JERRY COMISKEY

RECEIVED

OCT 01 1990


SECTION 30, T25S, R6W, W.M.

APPLICATION 69262 PERMIT 50150

WATER RESOURCES DE
 SALEM, OREGON



SCALE: 1 IN. = 1320 FEET

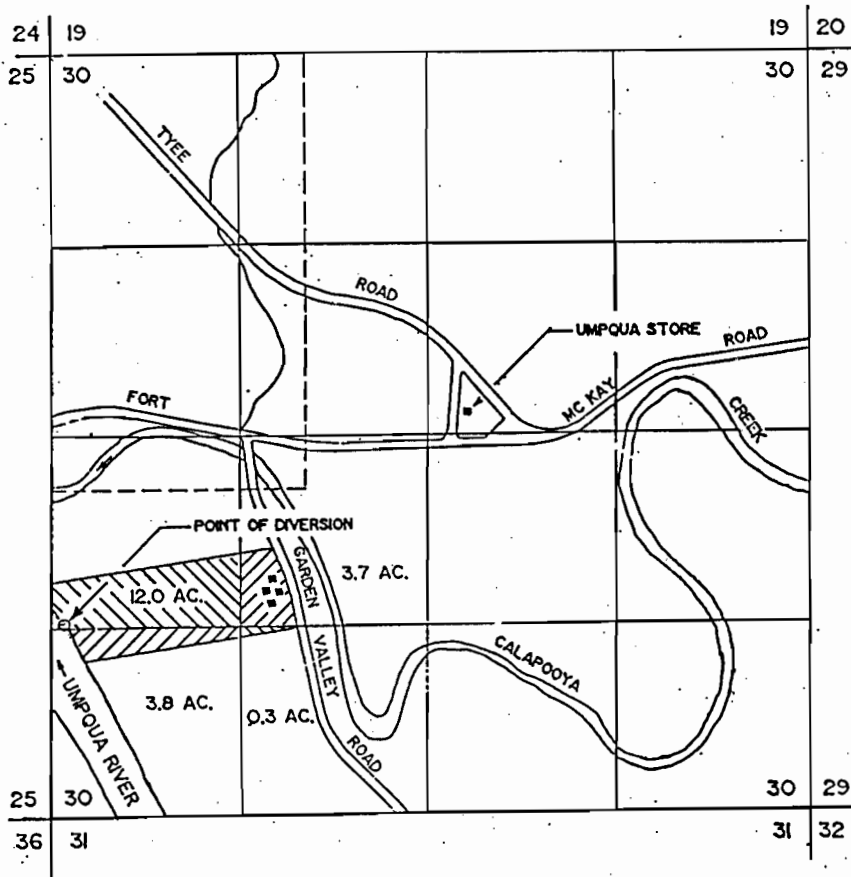

THE POINT OF DIVERSION IS LOCATED 1350 FEET NORTH
 AND 80 FEET EAST FROM THE SOUTHWEST CORNER OF SECTION 30,
 BEING WITHIN THE NORTH 1/4 OF THE SW 1/4 OF SECTION 30, T25S, R6W,
 W.M.

THE PURPOSE OF THIS MAP IS TO IDENTIFY THE LOCATION OF
 THE WATER RIGHT. IT IS NOT INTENDED TO PROVIDE INFOR-
 MATION RELATIVE TO THE LOCATION OF PROPERTY OWNERSHIP
 BOUNDARY LINES.

