



SECTION 10 T.3S., R.3W. W.M.
YAMHILL COUNTY

3 2
10 11

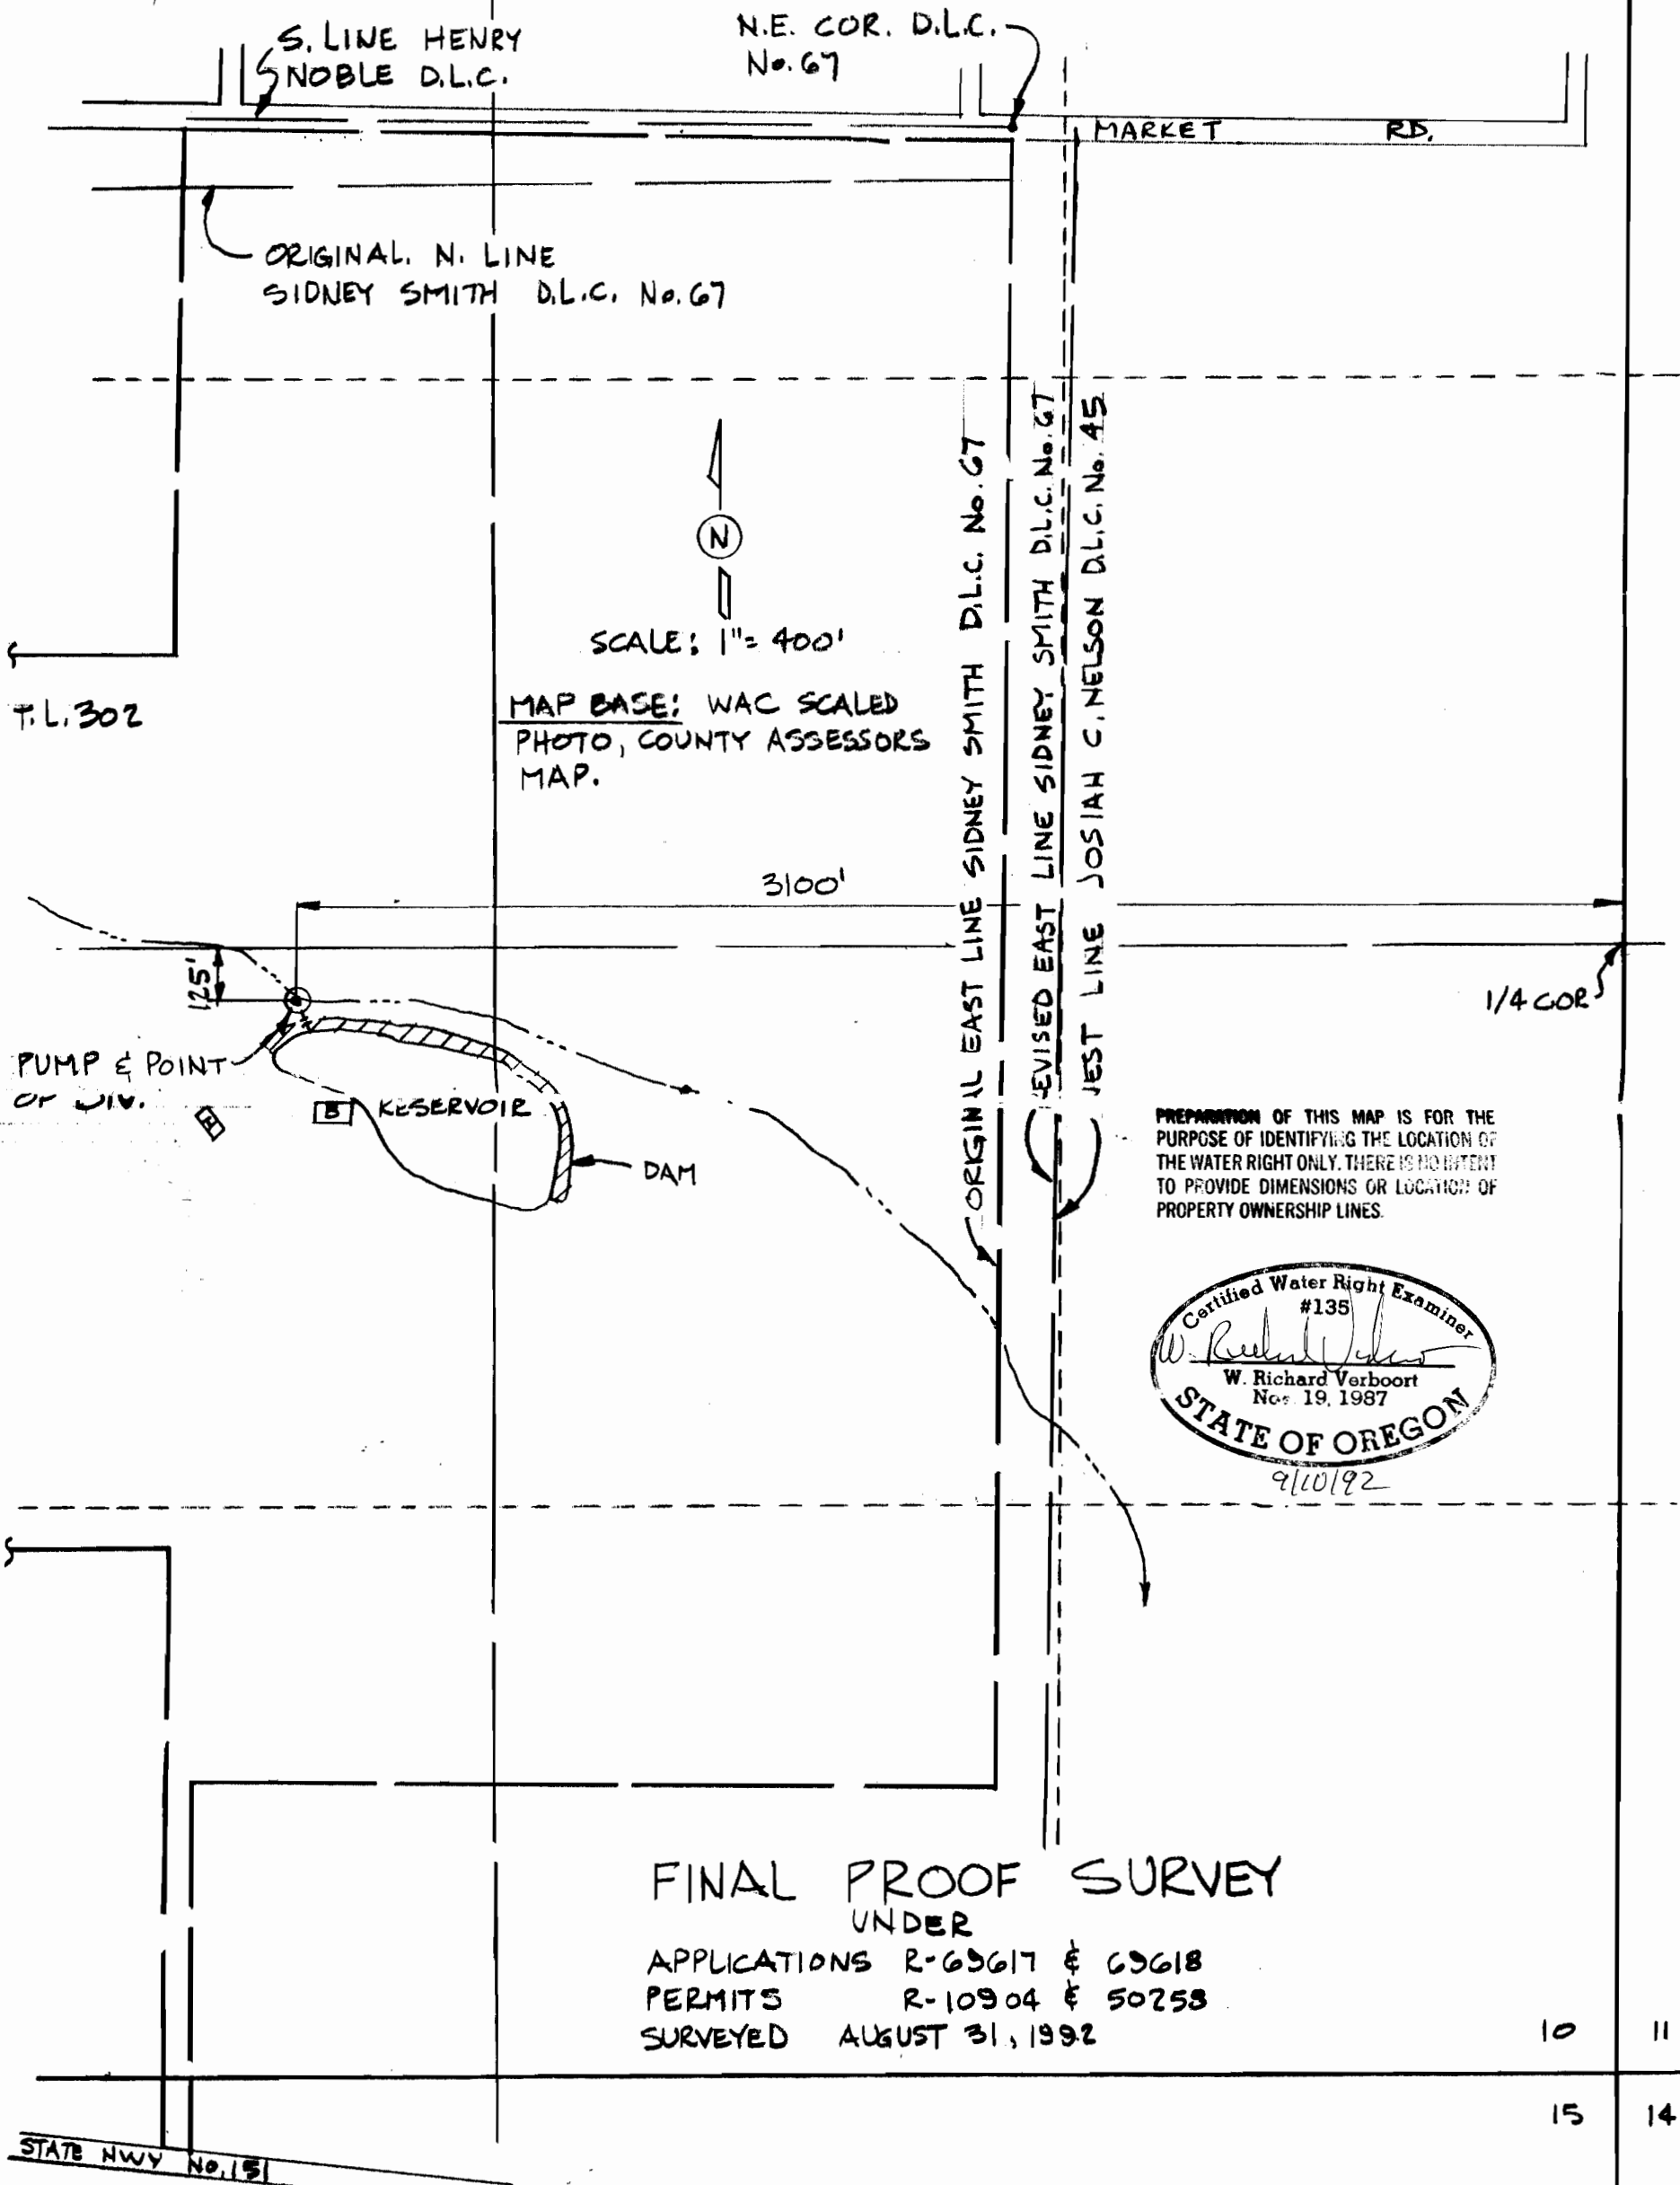

PREPARATION OF THIS MAP IS FOR THE PURPOSE OF IDENTIFYING THE LOCATION OF THE WATER RIGHT ONLY. THERE IS NO INTENT TO PROVIDE DIMENSIONS OR LOCATION OF PROPERTY OWNERSHIP LINES.

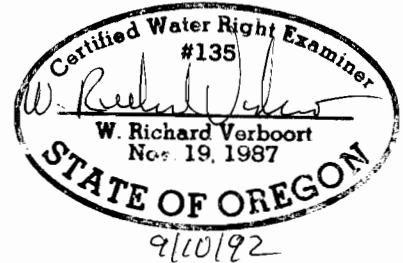

FINAL PROOF SURVEY
UNDER
APPLICATIONS R-69617 & 69618
PERMITS R-10904 & 50258
SURVEYED AUGUST 31, 1992

10 11
15 14

VERBOORT ENGINEERING
AGRICULTURE • CIVIL • WATER RESOURCES
HILLSBORO, OREGON

designed	WRV	9-8-92
drawn	JER	9-8-92
checked	WRV	9-8-92
drawing no.	92-B-12	
sheet no.	1/1	

BRUCE L. ENGEL
1215 S.W. HESSLER DRIVE
PORTLAND, OR 97201