
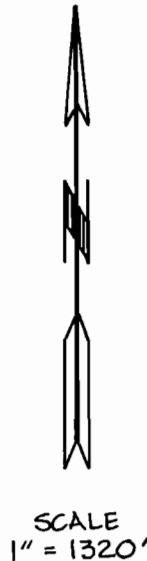


T3N R4W W.M.  
WASHINGTON COUNTY, OREGON

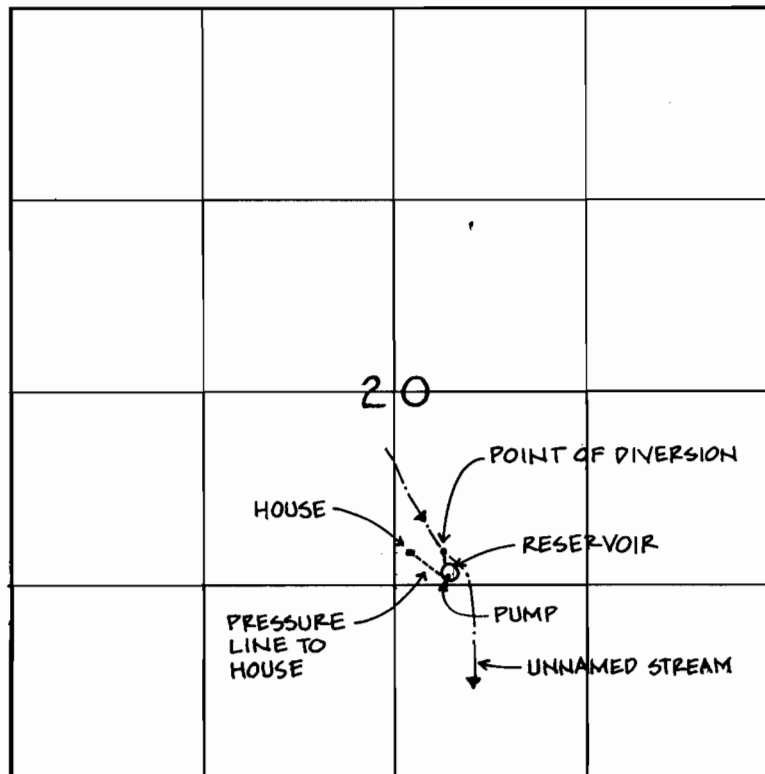

POINT OF DIVERSION • 1100' SOUTH & 350' EAST OF CENTER OF SECTION 20  
RESERVOIR • • • • • 1250' SOUTH & 400' EAST OF CENTER OF SECTION 20

THIS MAP DOES NOT INTEND TO  
PROVIDE DIMENSIONS FOR THE  
EXACT LOCATION OF PROPERTY  
OR BOUNDARY LINES.

CHARLES E. SPEAR CWRE #187  
831 N.E. BIRCHAIRE LN.  
HILLSBORO, OREGON 97124

FINAL PROOF SURVEY  
UNDER

Application No. R-69702  
69703

Permit No. R-11101  
50653

IN NAME OF  
MARK A. NATIONS

SURVEYED MAY 8, 1992

