


T3N R4W W.M.
WASHINGTON COUNTY, OREGON

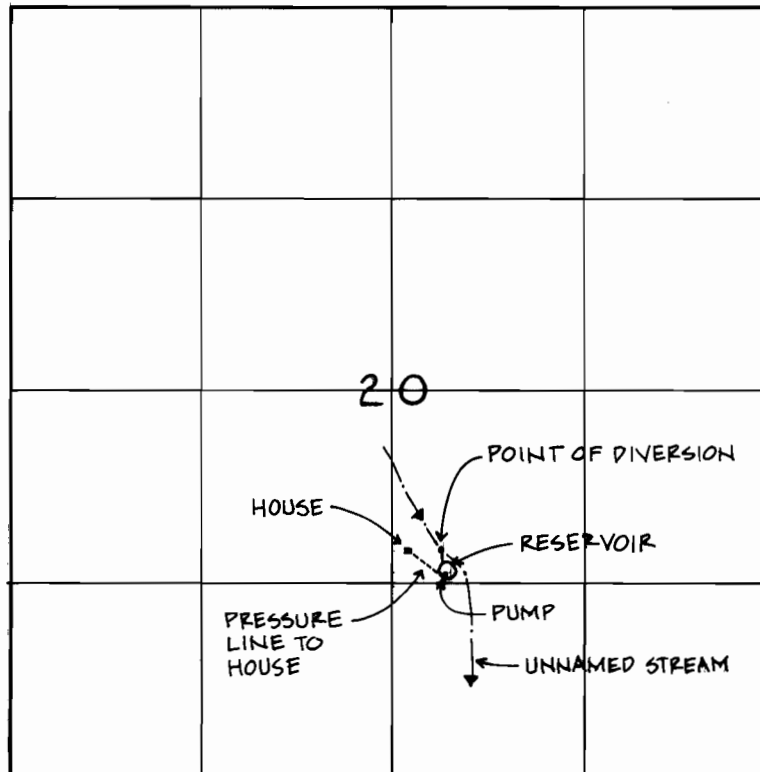

SCALE
1" = 1320'

POINT OF DIVERSION • 1100' SOUTH & 350' EAST OF CENTER OF SECTION 20
RESERVOIR • 1250' SOUTH & 400' EAST OF CENTER OF SECTION 20

THIS MAP DOES NOT INTEND TO
PROVIDE DIMENSIONS FOR THE
EXACT LOCATION OF PROPERTY
OR BOUNDARY LINES.

CHARLES E. SPEAR CWRE #187
831 N.E. BIRCHAIRE LN.
HILLSBORO, OREGON 97124

FINAL PROOF SURVEY
UNDER

Application No. R-69702
69703

Permit No. R-11101
50653

IN NAME OF

MARK A. NATIONS

SURVEYED MAY 8, 1992

