
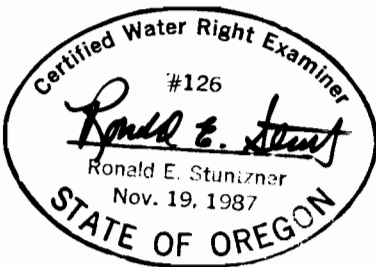


T.25 S., R.12 W.W.M.

SECTION 29

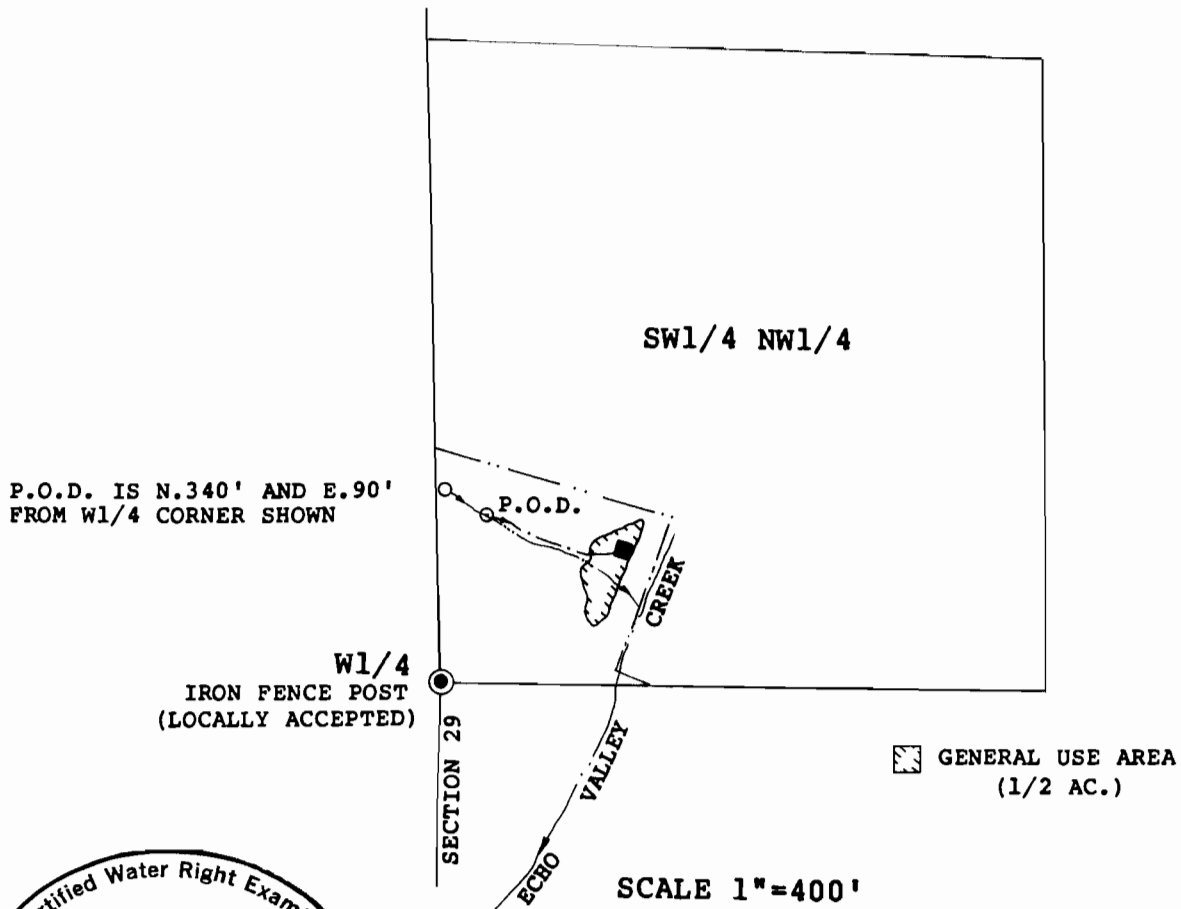

FINAL PROOF SURVEY

UNDER

APPLICATION NO. 70127 PERMIT NO. 50848

IN THE NAME OF

A. JO AN CONWAY

SURVEYED SEPT. 24, 1992 BY CWRE RONALD E. STUNTNER