



T.35 S., R.2 W., W.M.

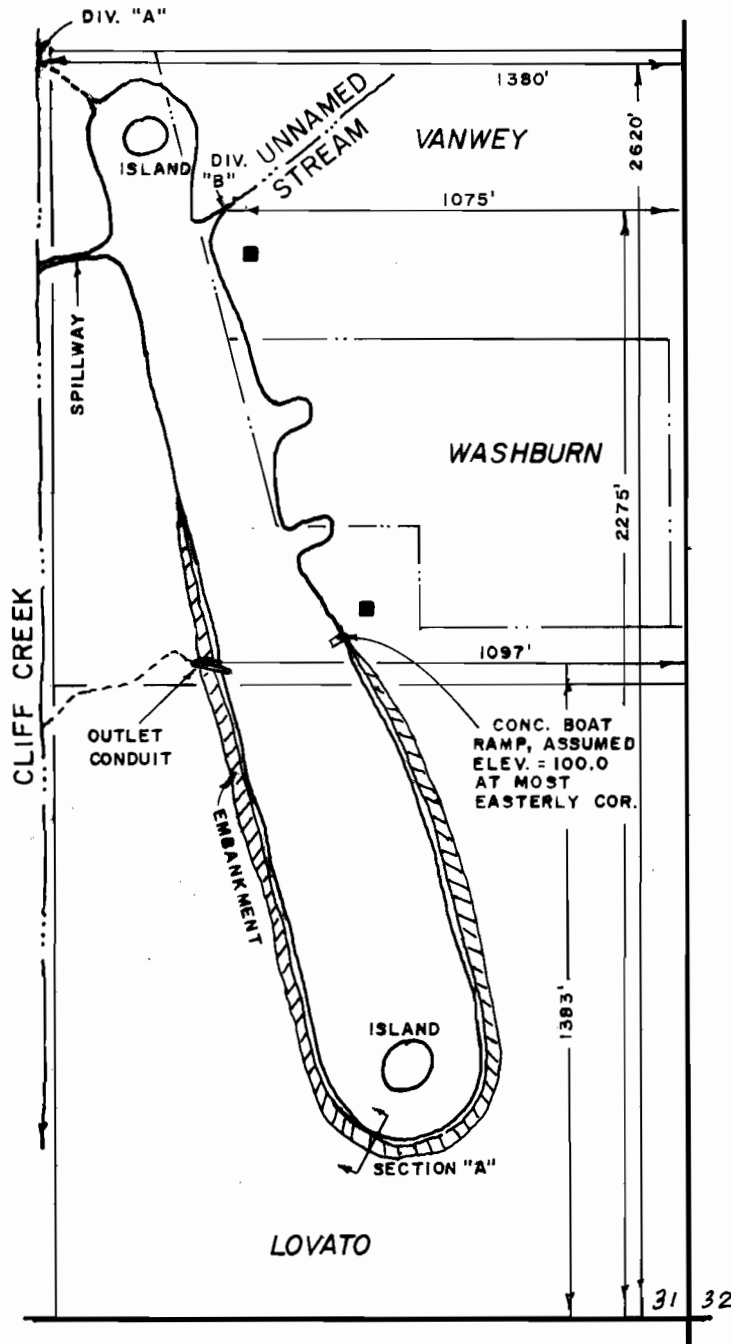

SCALE : 1" = 400'

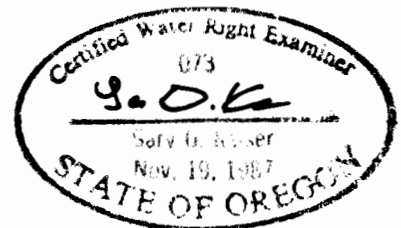

FINAL PROOF MAP

APPLICATION NOS R-70284 & 70285

PERMIT NOS R-11428 & 51395

NOTE THIS MAP HAS BEEN
PREPARED FOR WATER RIGHT
PURPOSE ONLY, NOT FOR
PROPERTY BOUNDARY LOCATION

IN THE NAMES OF

WAYNE & GINGER VANWEY

JOE & BETTY LOVATO

DEBBIE & KENT WASHBURN

MAP PREPARED AUGUST 31, 1992
BY GARY D. KAISER