


T. 27 S., R. 12 W. W.M.

Scale: 1" = 400ft.

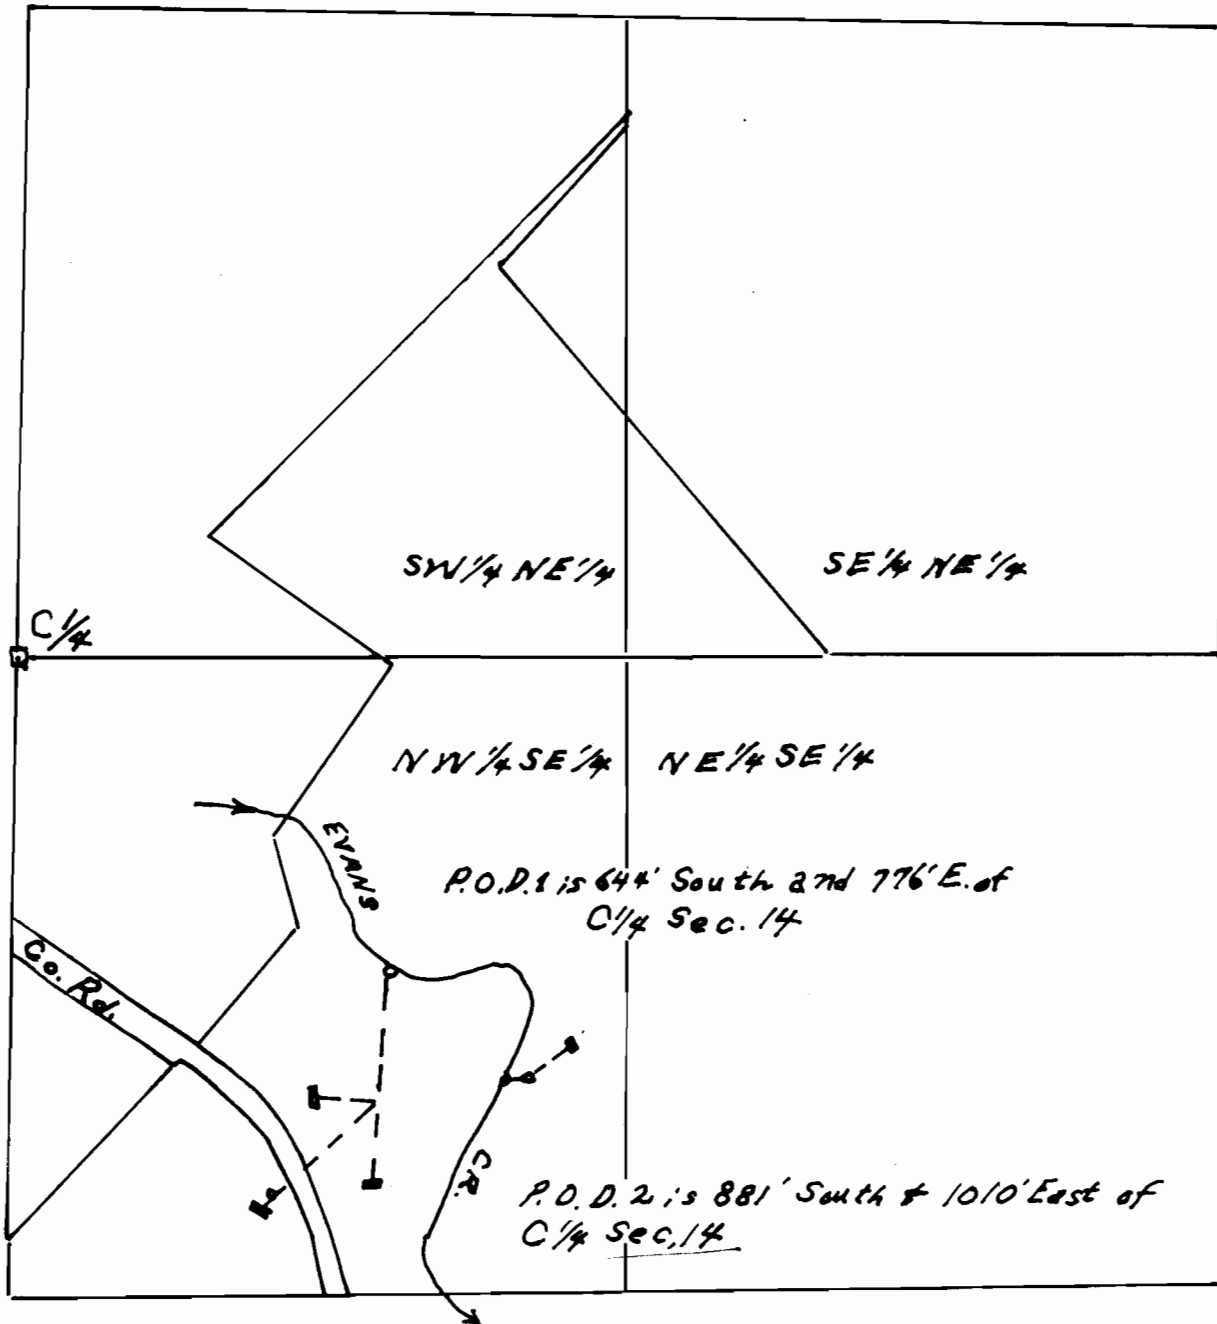

FINAL PROOF SURVEY  
UNDER

Application No. 70539

Permit No. 51359

IN NAME OF J. C. and June STEWART

Surveyed March 24, 1992 by:

This map is not the result of a property survey and is not to be used as such.

