



TOWNSHIP 26 SOUTH, RANGE 4 WEST, W.M.  
SECTIONS 13 & 24

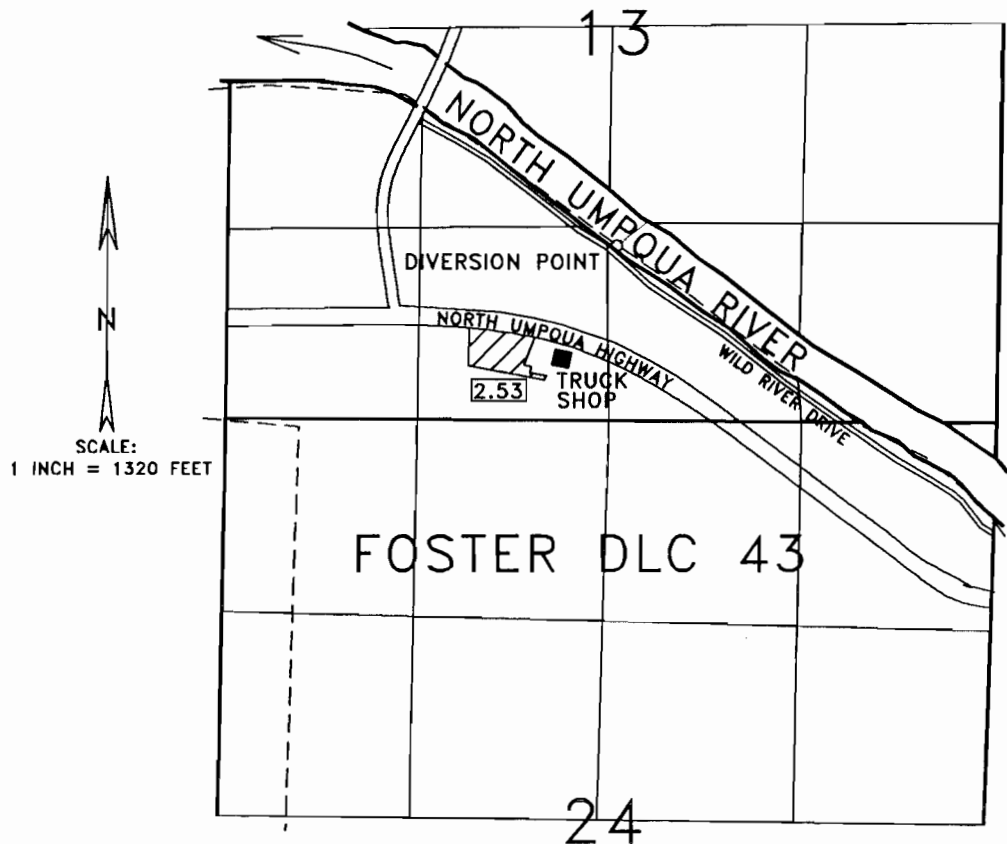


DIVERSION POINT IS LOCATED 1200 FEET NORTH AND 2580 FEET WEST  
FROM THE SOUTHEAST CORNER OF SECTION 13.

FINAL PROOF SURVEY  
for  
A.J. UPDEGRAVE  
APPLICATION 70836 PERMIT 51288

THE PURPOSE OF THIS MAP IS TO IDENTIFY  
THE LOCATION OF THE WATER RIGHT. IT IS  
NOT INTENDED TO PROVIDE INFORMATION  
RELATIVE TO THE LOCATION OF PROPERTY  
OWNERSHIP BOUNDARY LINES.

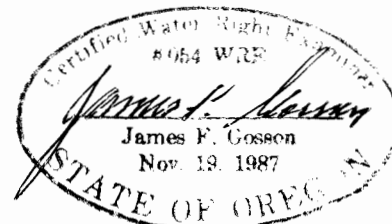

TOWNSHIP 26 SOUTH, RANGE 4 WEST, W.M.  
SECTIONS 13 & 24

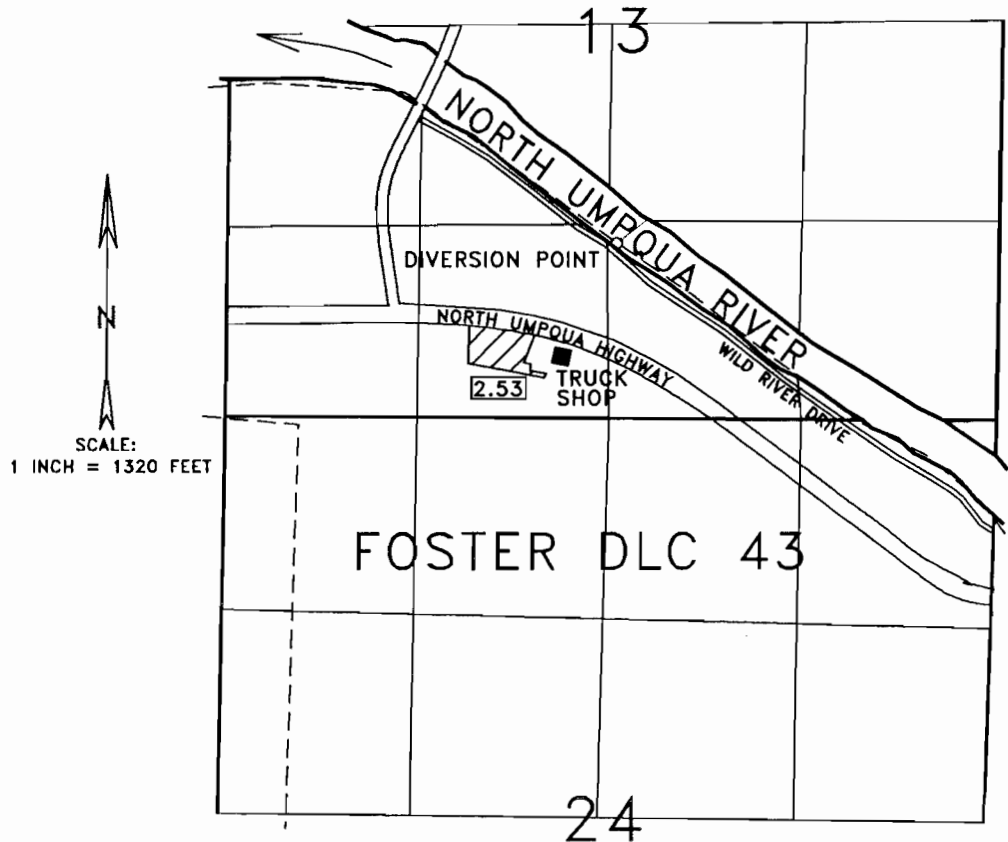

DIVERSION POINT IS LOCATED 1200 FEET NORTH AND 2580 FEET WEST  
FROM THE SOUTHEAST CORNER OF SECTION 13.

FINAL PROOF SURVEY  
for  
A.J. UPDEGRAVE

APPLICATION 70836 PERMIT 51288

THE PURPOSE OF THIS MAP IS TO IDENTIFY  
THE LOCATION OF THE WATER RIGHT. IT IS  
NOT INTENDED TO PROVIDE INFORMATION  
RELATIVE TO THE LOCATION OF PROPERTY  
OWNERSHIP BOUNDARY LINES.

