T. 9S. R.5W. W.M.

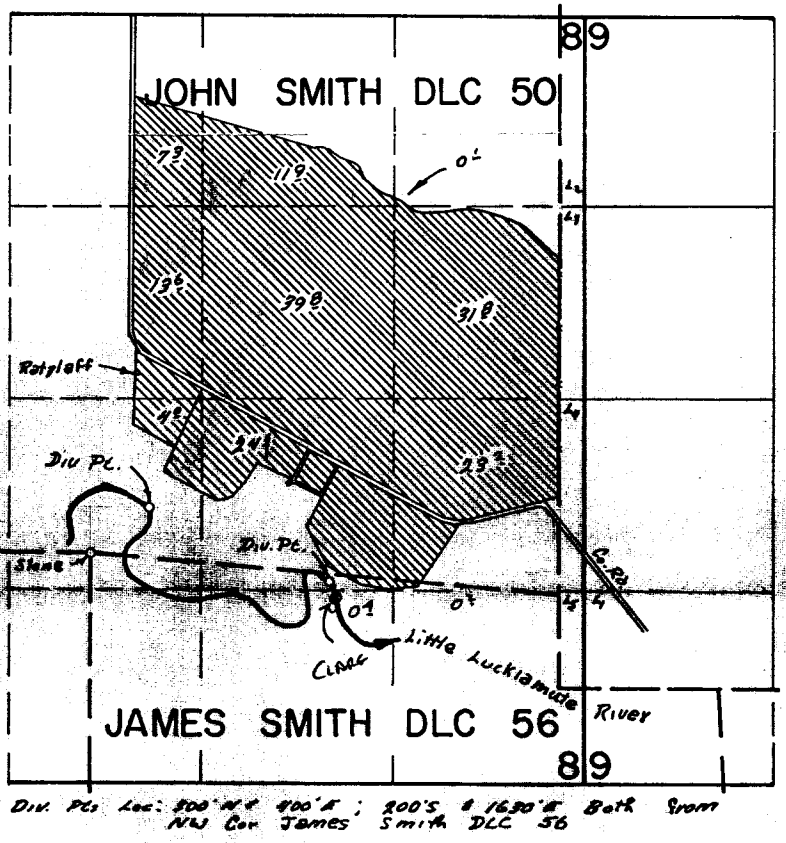

FINAL PROOF SURVEY
UNDER

Application No. 42958 Permit No. 22204
IN NAME OF

VERDA CROOK

Surveyed March 29 1973, by R. B. Mucken

DFP-1LL-20 TP