


P 6 10563 63329

T. 2 N. R. 20 E. W.M.

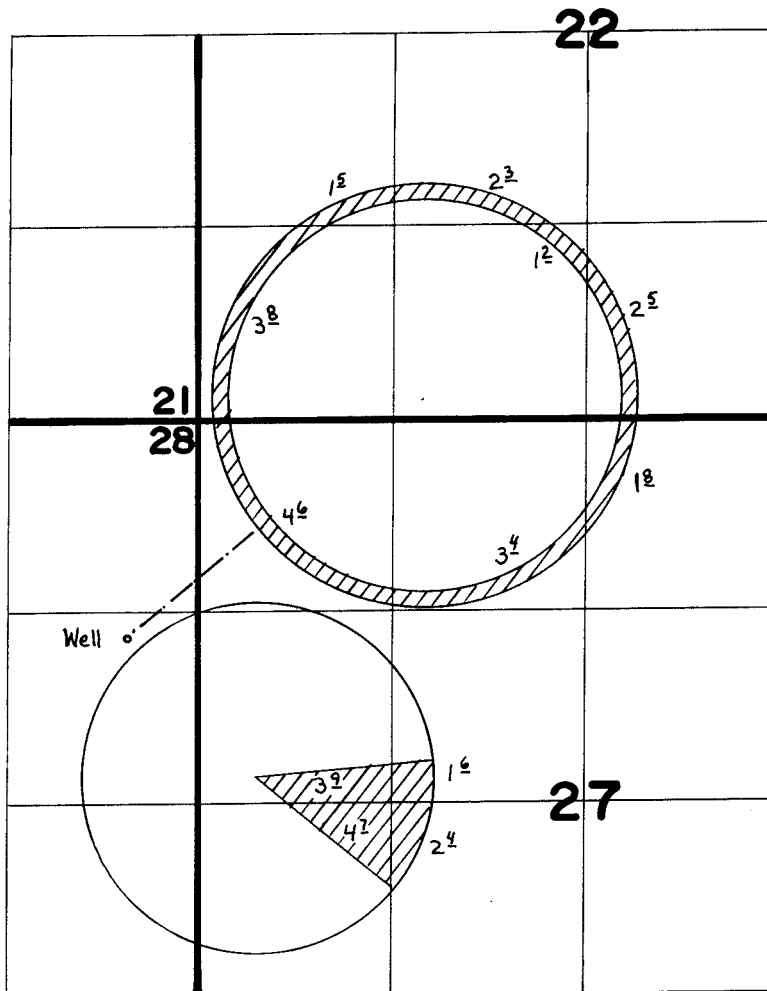

WELL LOC. - 1500' S. & 500' W. FROM N.E. COR. NE. 1/4 N.E. 1/4 SEC. 28

FINAL PROOF SURVEY

UNDER

Application No. G11450... Permit No. G10563.....
IN NAME OF

STONE MACHINERY COMPANY, INC.

Surveyed May...12... 1986, by ..V..Church.....