


T. 39S., R. 13E., W.M.

R-8309  
68332

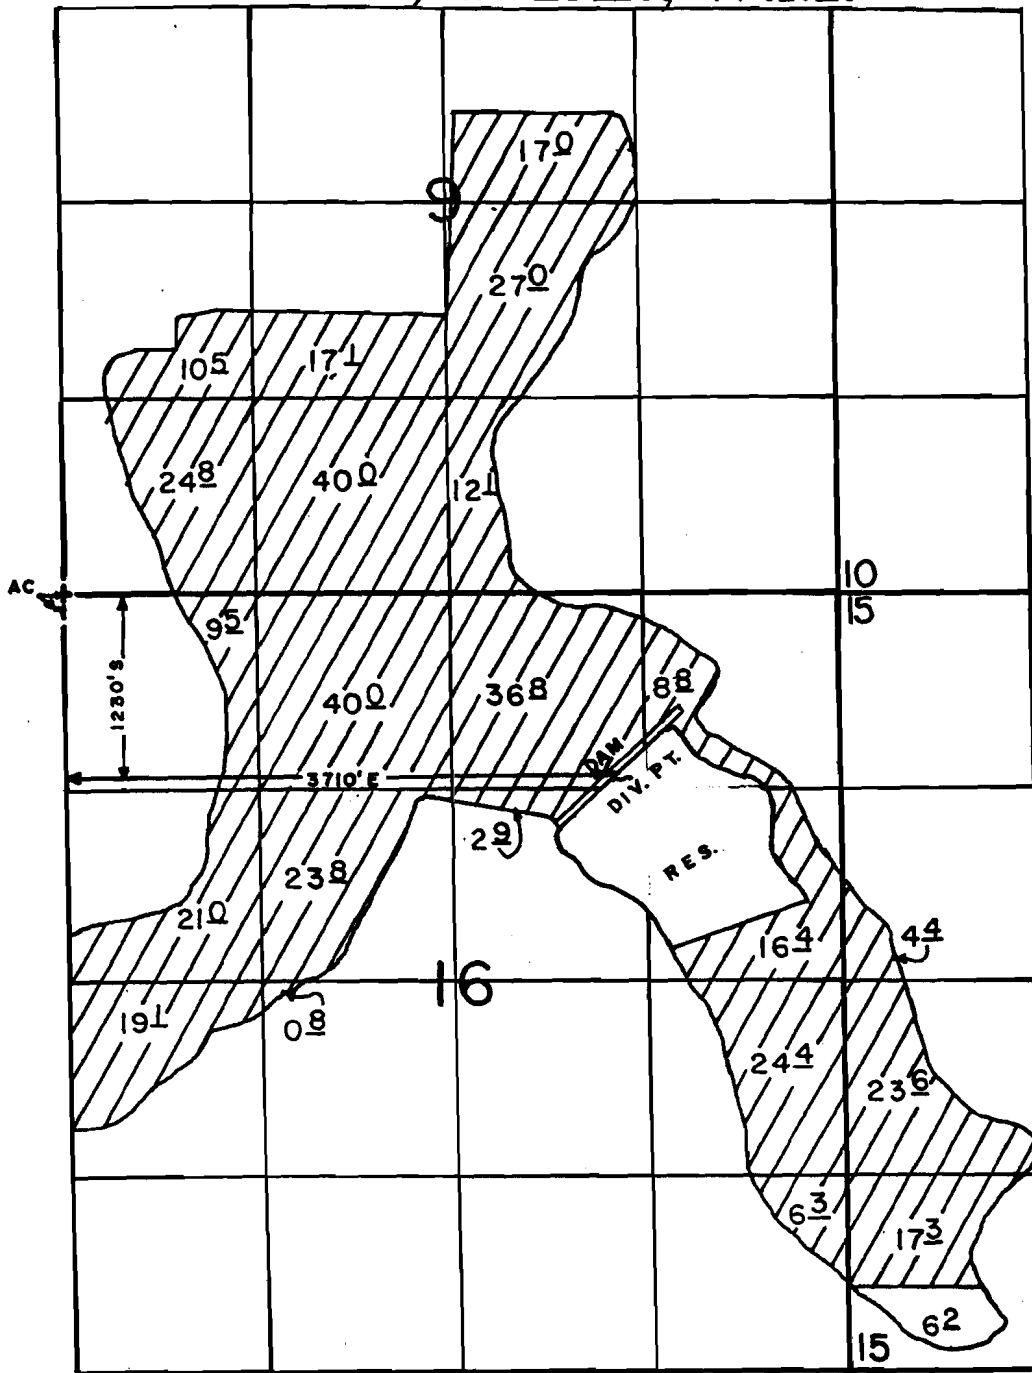

FINAL PROOF SURVEY

UNDER

R-61781                      R-8309  
Application No. 61782      Permit No. 46064  
IN NAME OF

ROBERT M. NEWSOM

Surveyed NOV 8., 1991, by D. SPARKS

SCALE: 1" = 1320'

Millers Crk. & Misc.