


T. 39S., R. 13E., W.M.

46064
68333

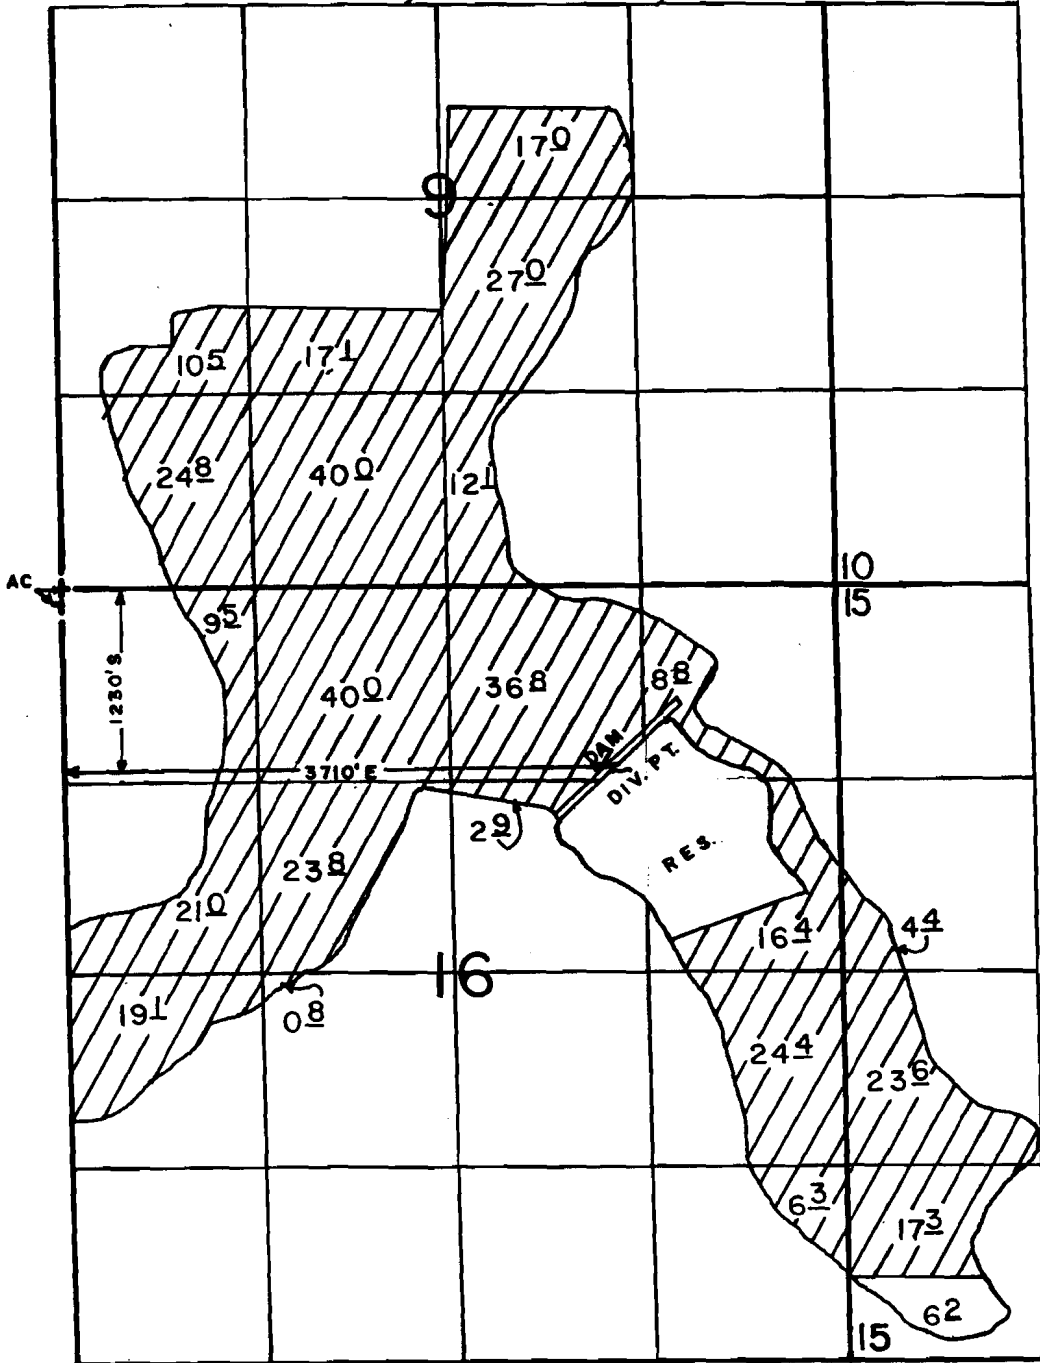

FINAL PROOF SURVEY

UNDER

R-61781 R-8309
Application No. 61782 Permit No. 46064
IN NAME OF

ROBERT M. NEWSOM

Surveyed NOV 8., 1991, by D. SPARKS

SCALE: 1" = 1320'

Miller Ck & Misc.