

1" = 100'

FINAL PROOF SURVEY

UNDER

Application No. 68322 Permit No. 49342


IN NAME OF

JOSEPH E. LAACK

Surveyed May 14 19 91, by R. W. KLASSEN

N. SANTIAM RIVER

See Map 9 3E 30DC

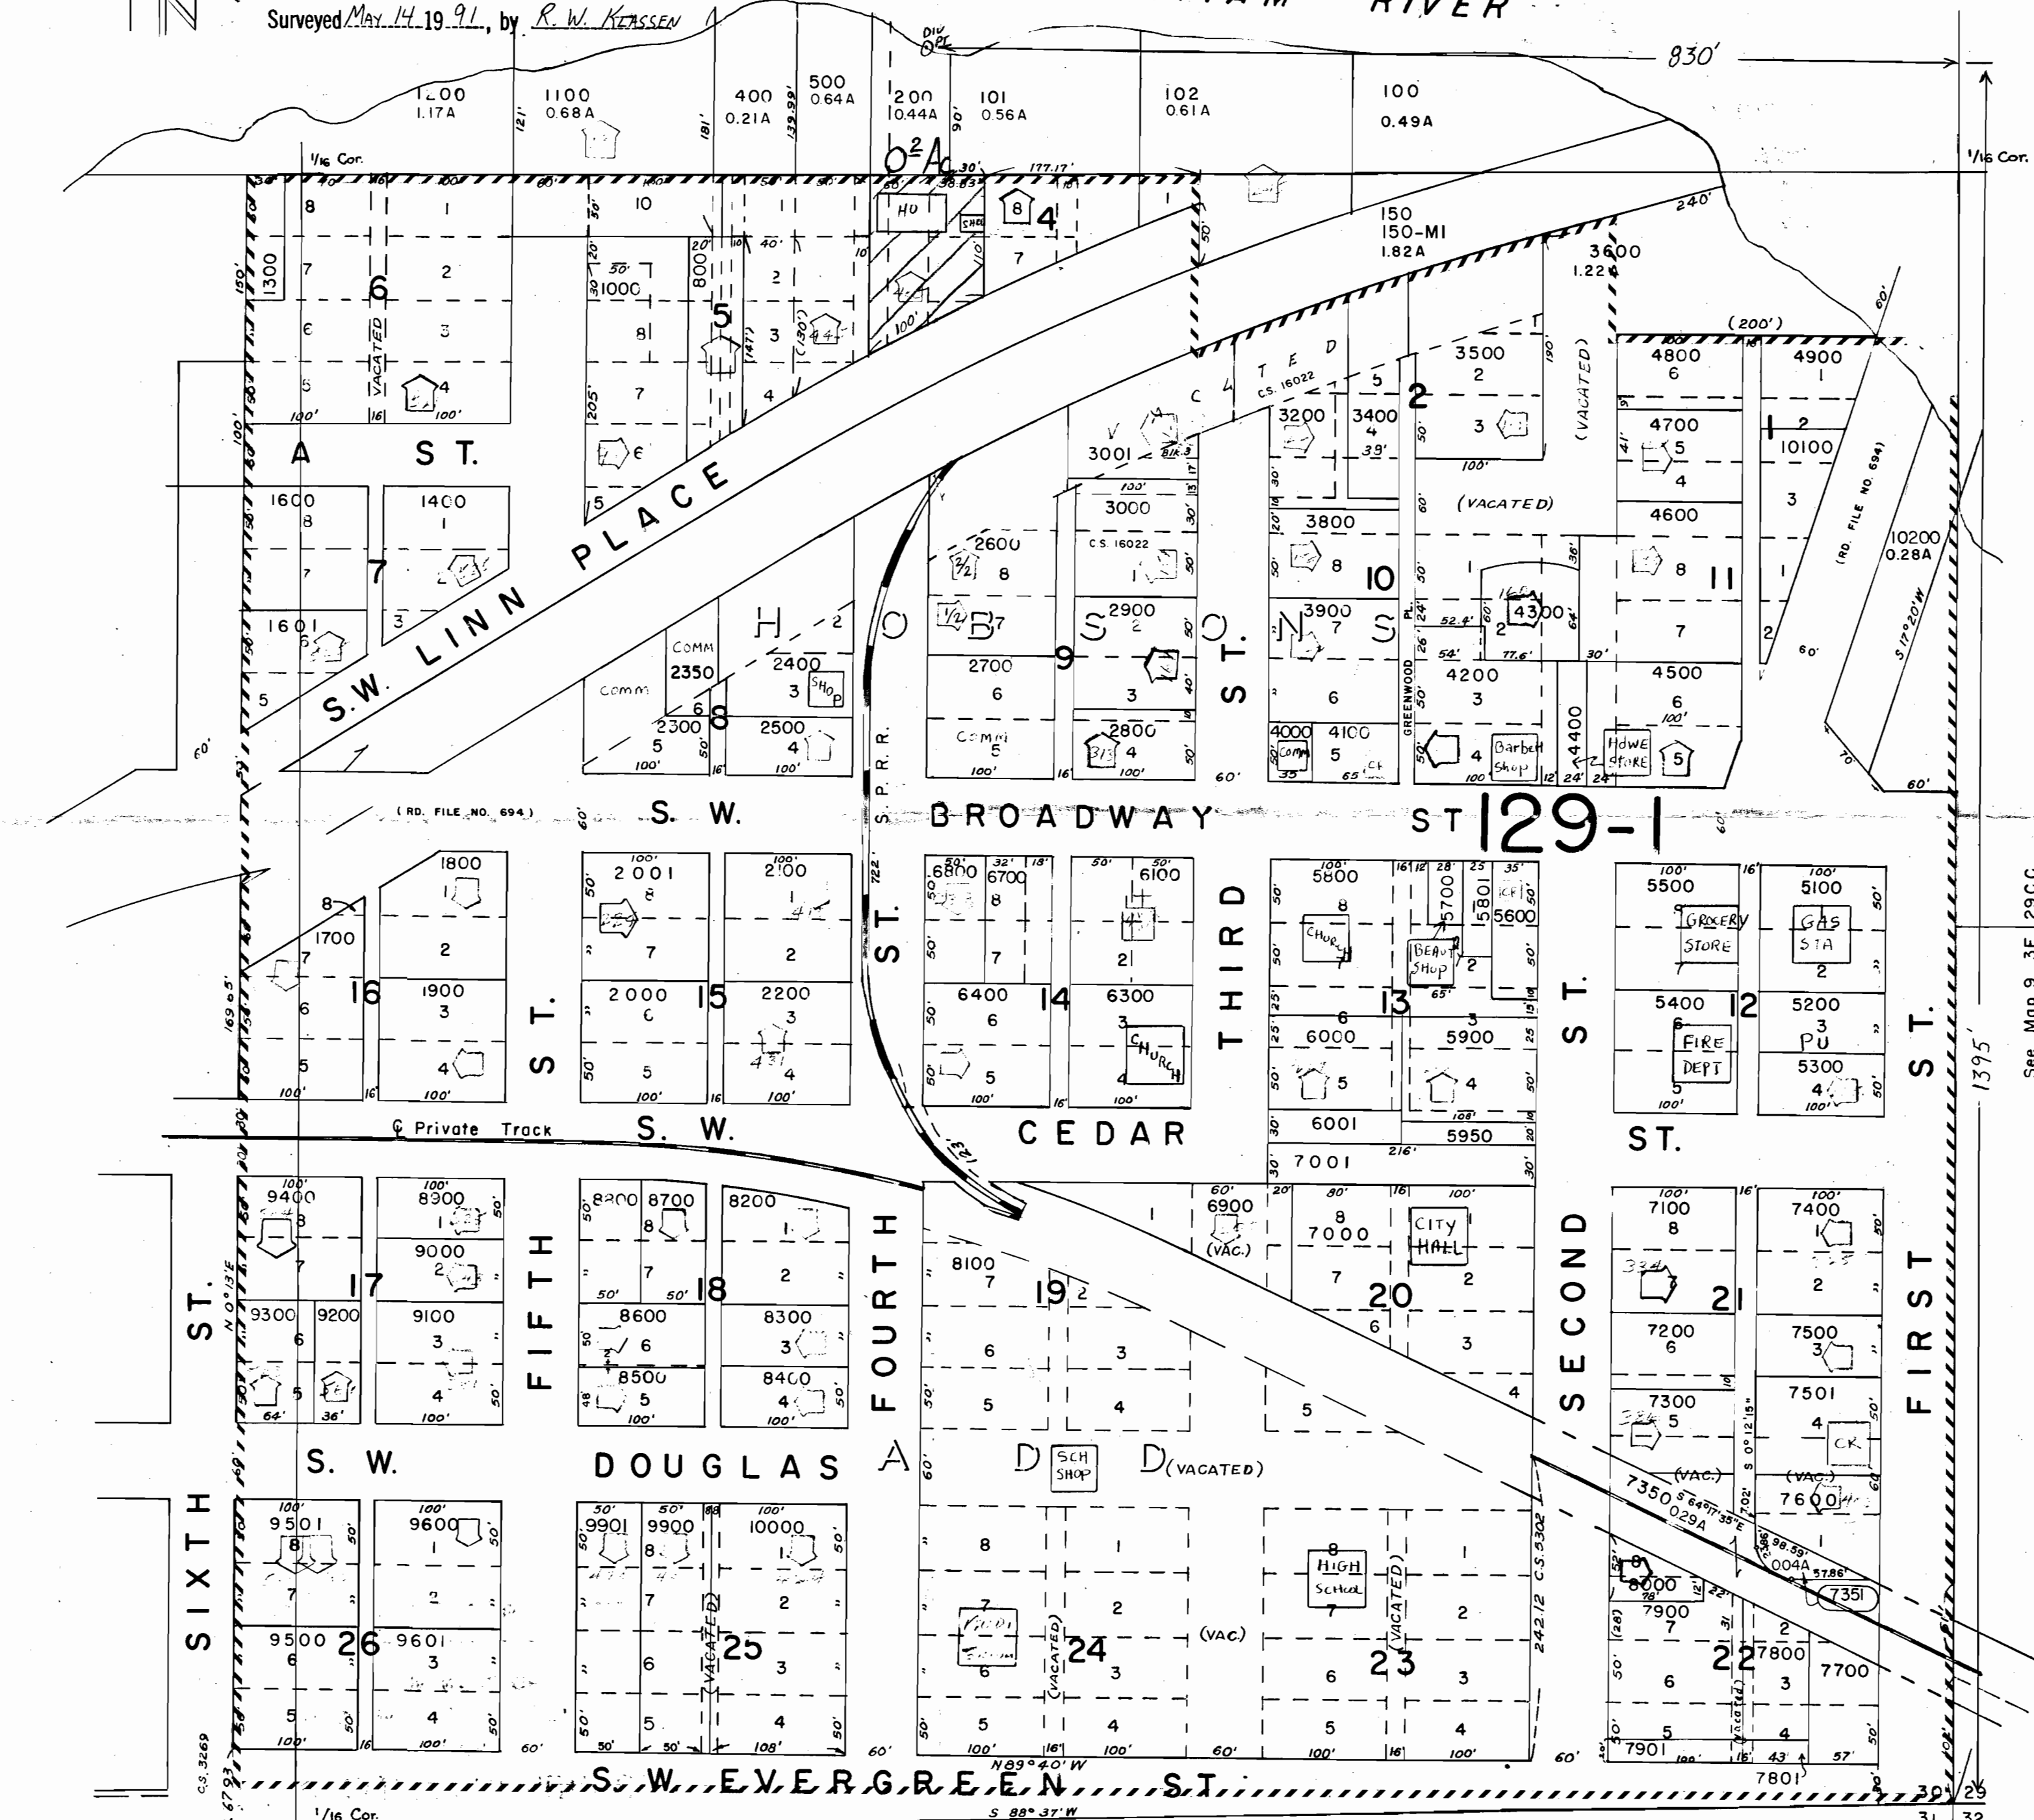

See Map 9 3E 29CC

See Map 9 3E 31AA

MILL CITY