

Township 7 South, Range 4 West, W.M.
W 1/2 SW 1/4, Section 24

RECEIVED


NOV 0 1992

WATER RESOURCES DEPT.
SALEM OREGON

N



1" = 400'

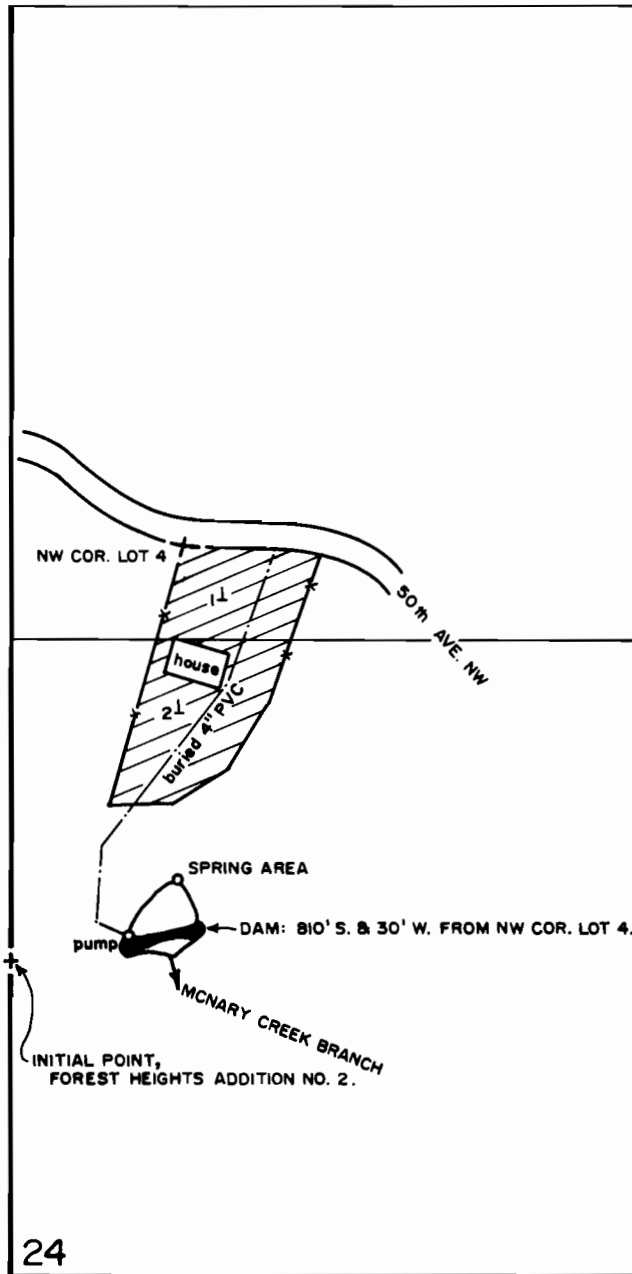

FINAL PROOF SURVEY

under

Appl. No. R-69911, Per. No. R-11161


69912

50743

in name of

FRANK WOOD

November 11, 1992

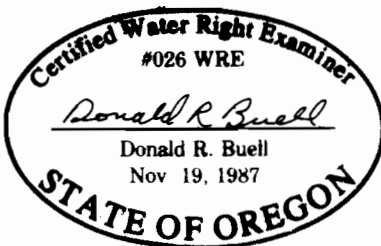

THIS MAP WAS PREPARED FOR THE PURPOSE OF IDENTIFYING THE LOCATION OF A WATER RIGHT ONLY AND IS NOT INTENDED TO PROVIDE LEGAL DIMENSIONS OR LOCATION OF PROPERTY OWNERSHIP LINES.