


T.24&25S.R.11W.W.M.

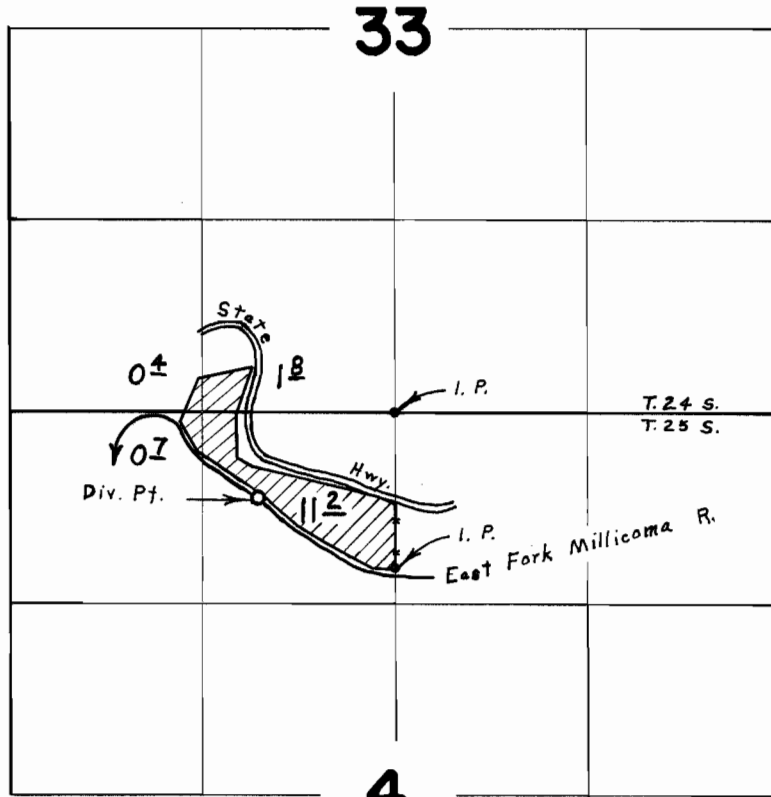

Div. Pt. Located 590' S. & 940' W. From The N. $\frac{1}{4}$ Cor. Sec. 4

FINAL PROOF SURVEY UNDER

Application No. 40478 Permit No. 30164
IN NAME OF

ALVA LEE AND/OR RITA JEAN MOSER

Surveyed Sept. 23, 1966, by L. E. Gould