


T.34S., R.1W., W.M.

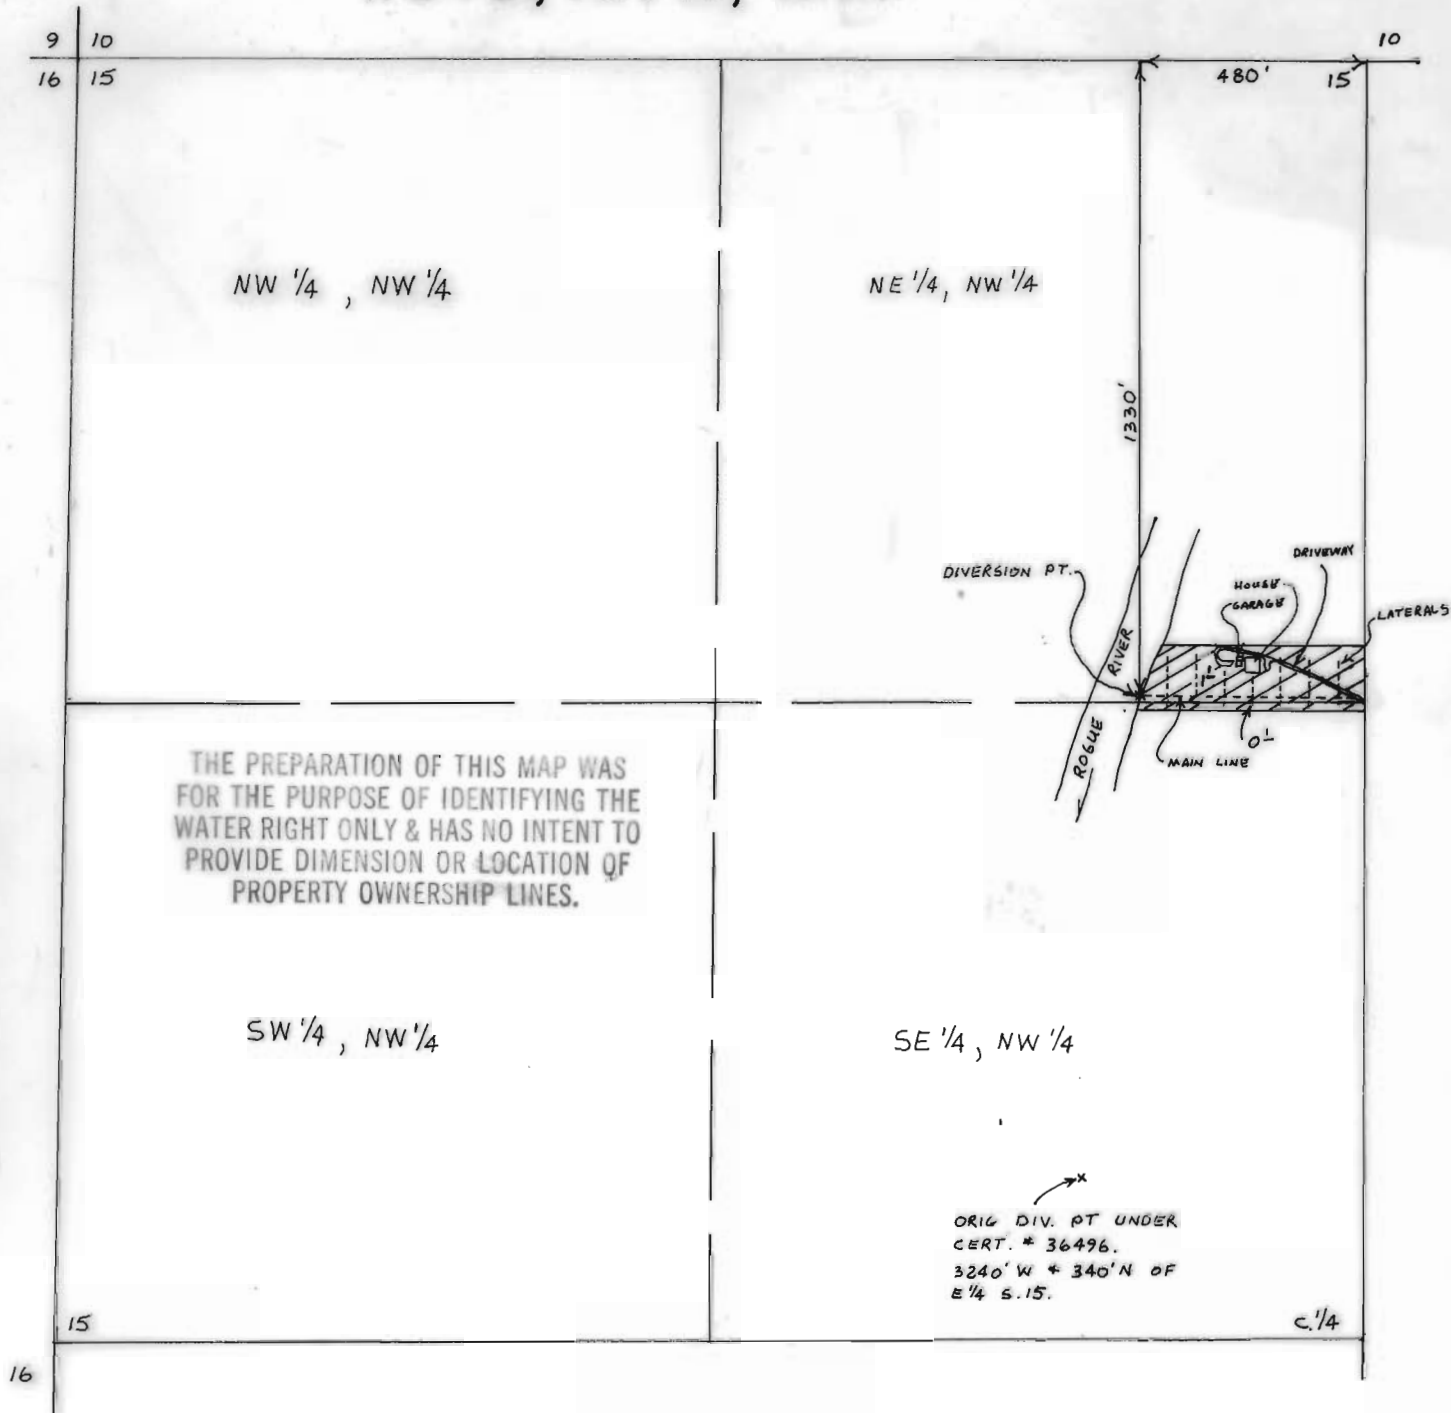

THE PREPARATION OF THIS MAP WAS FOR THE PURPOSE OF IDENTIFYING THE WATER RIGHT ONLY & HAS NO INTENT TO PROVIDE DIMENSION OR LOCATION OF PROPERTY OWNERSHIP LINES.

FINAL PROOF MAP
under

Application No. T-6398 Permit No. 12635
In Name Of

RICHARD J. ATKINSON

Mapped: AUGUST 22, 1991 Scale: 1"=400'

Mapped By: L. J. Friar & Associates P.C.
Consulting Land Surveyors
304 South Holly Street
Medford, OR 97501
(503) 772-2782

