
T.5S.R.IW.W.M.

## RECEIVED

AUG 1 9 1992

WATER RESOURCES DEPT. SALEM, OREGON

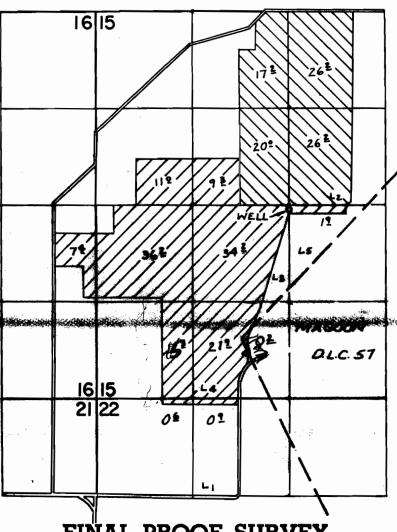

FINAL PROOF SURVEY

UNDER

6-13082 WELL LOC: 2720'S FROM N' COR SEC. 15 SUPPLEMENTAL

Application No. G-6775 Permit No. G-5479 IN NAME OF

BUTSCH BROTHERS

Surveyed AUG. 3. 1976, by R. MUCKEN