


T. 2N. R. 27E. W.M.

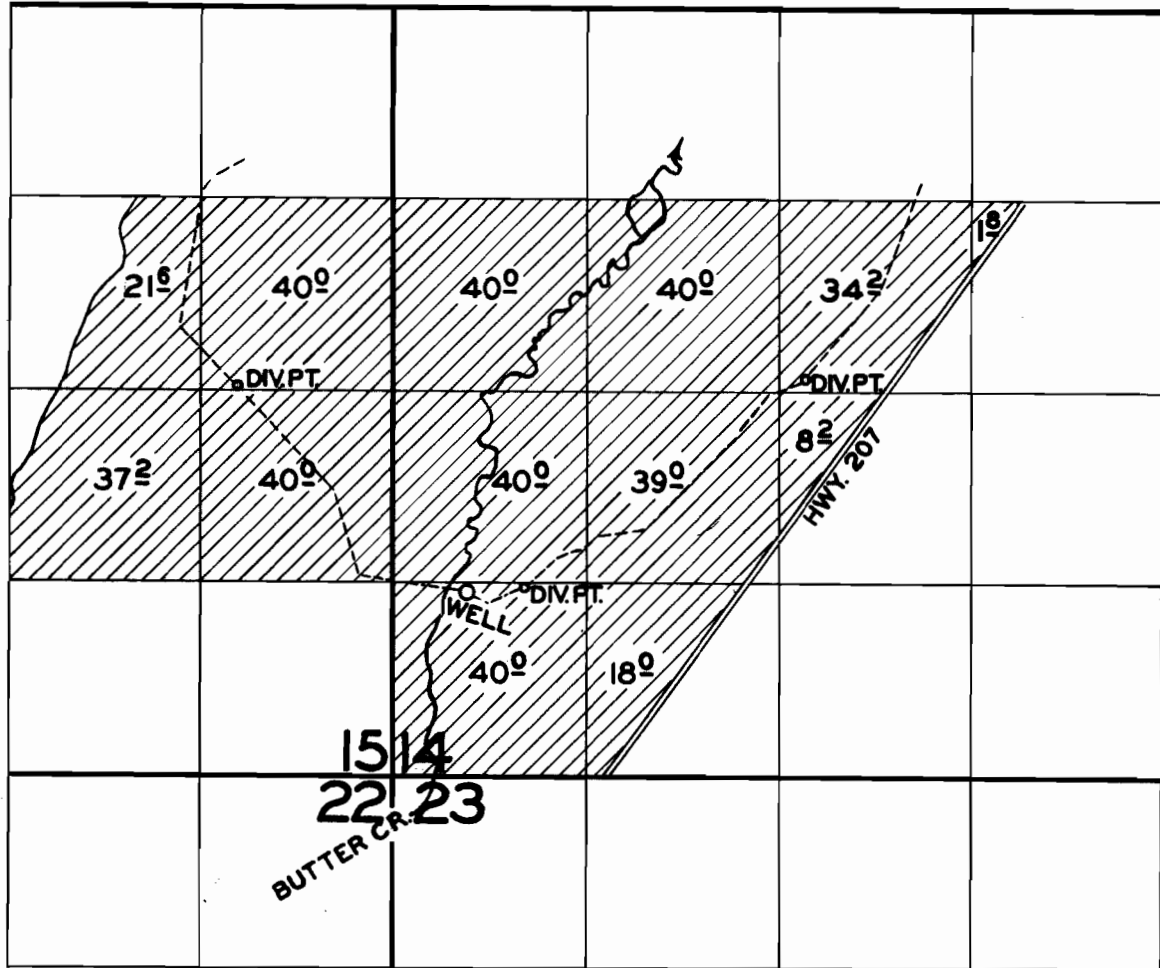

FINAL PROOF SURVEY

UNDER

Application No. U-468 Permit No. U-425

IN NAME OF

OSCAR D. MCCARTY

Surveyed MAY 28 1957, by C. O. Burtels