


T.22 S.R.8W.W.M.

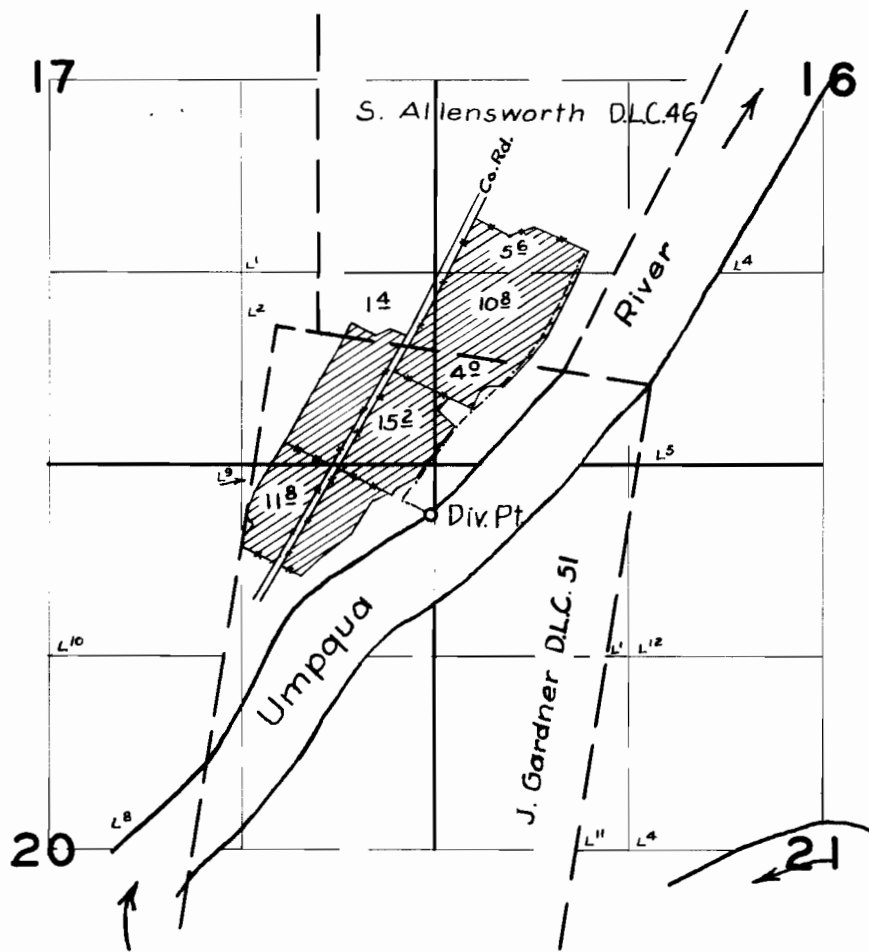

FINAL PROOF SURVEY UNDER

Application No. 27959 Permit No. 22010
IN NAME OF

C. G. Hedden

Surveyed Sept. 9, 1957, by M. Bish