


T. 13S. R. 1W. W.M.

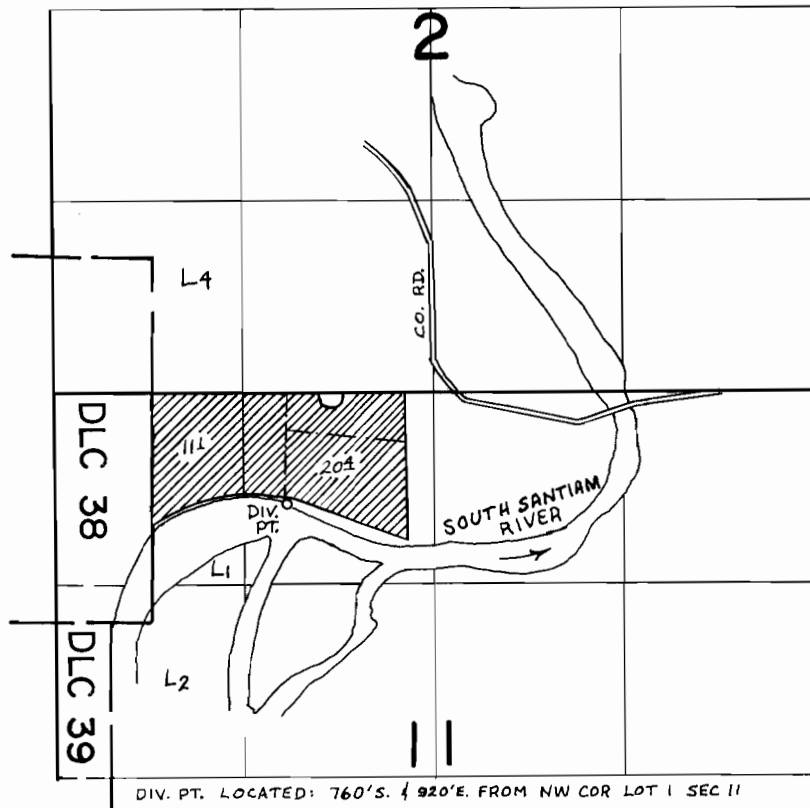

FINAL PROOF SURVEY
UNDER

Application No. 48816..... Permit No. 36592.....
IN NAME OF

..... W. A. & WINNIFRED A. BATES

Surveyed NOV. 6... 1974., by D. NORBY.....