







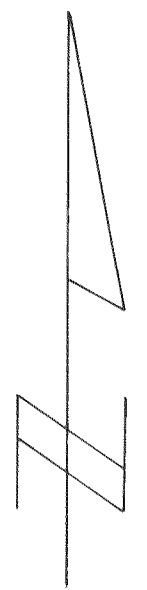


Twp. 13 S., Rng. 4 W., WM.

LEGEND

-  Permit 50921
-  Permit 37877
-  Permit 42759
-  Permit 43710
-  Permit 45980
-  Certificate 51589
-  Certificate 82148
-  Certificate 82281

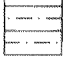

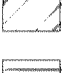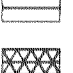SCALE 1" = 1320'


FINAL PROOF SURVEY

UNDER

Application 49527	Permit 37877
55400	42759
57947	43710
58932	45980
68824	50921

IN NAME OF
MUDDY CREEKS IRRIGATION PROJECT

Surveyed 1993 By R.W.Klassen

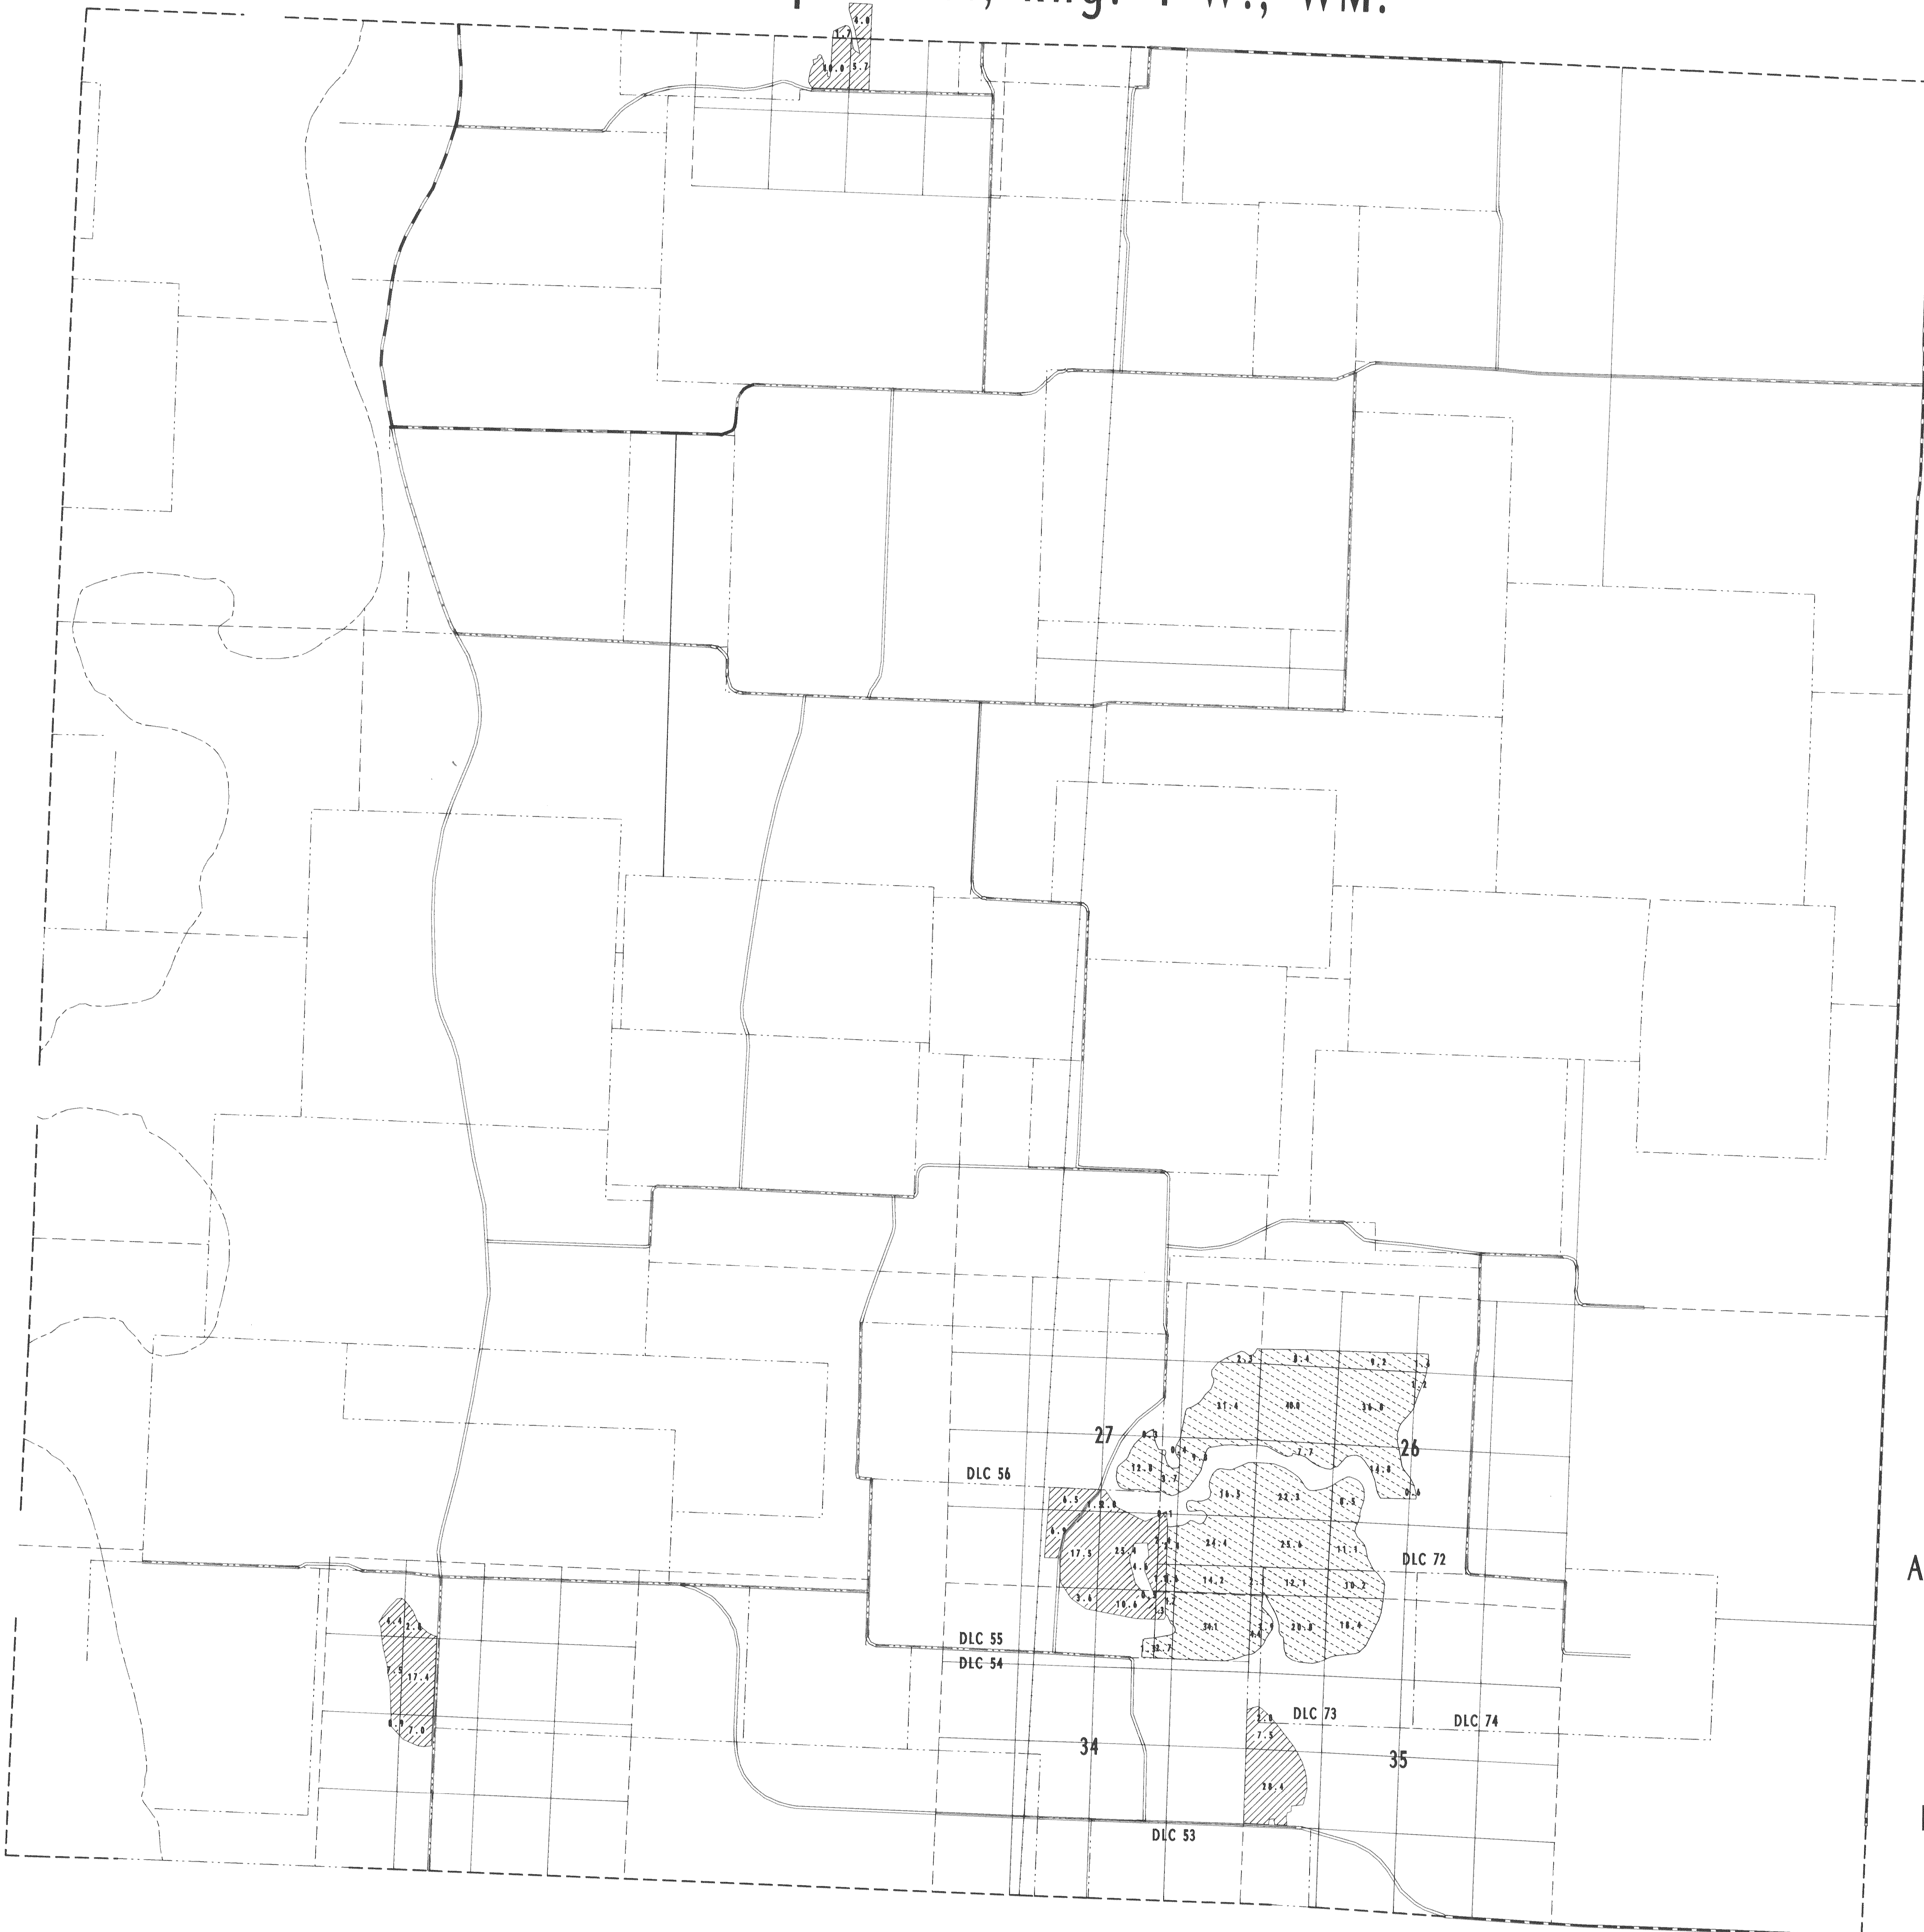


User: rwnk\k...
 Date: 11/11/94 11:24 AM
 Path: \\...
 File: ...

Twp. 15 S., Rng. 4 W., WM.




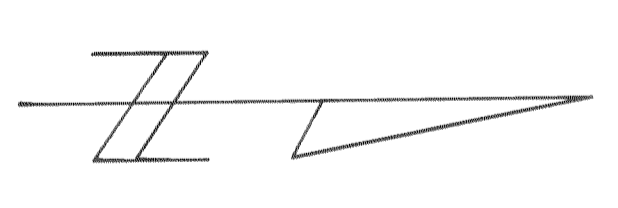

SCALE 1" = 1320'

FINAL PROOF SURVEY
UNDER

Application 49527	Permit 37877
55400	42759
57947	43710
58932	45980
68824	50921

IN NAME OF
MUDDY CREEKS IRRIGATION PROJECT
 Surveyed 1993 By R.W.Klassen


ANTHELM:JAN:1993





Twp. 15 S., Rng. 3 W., WM.

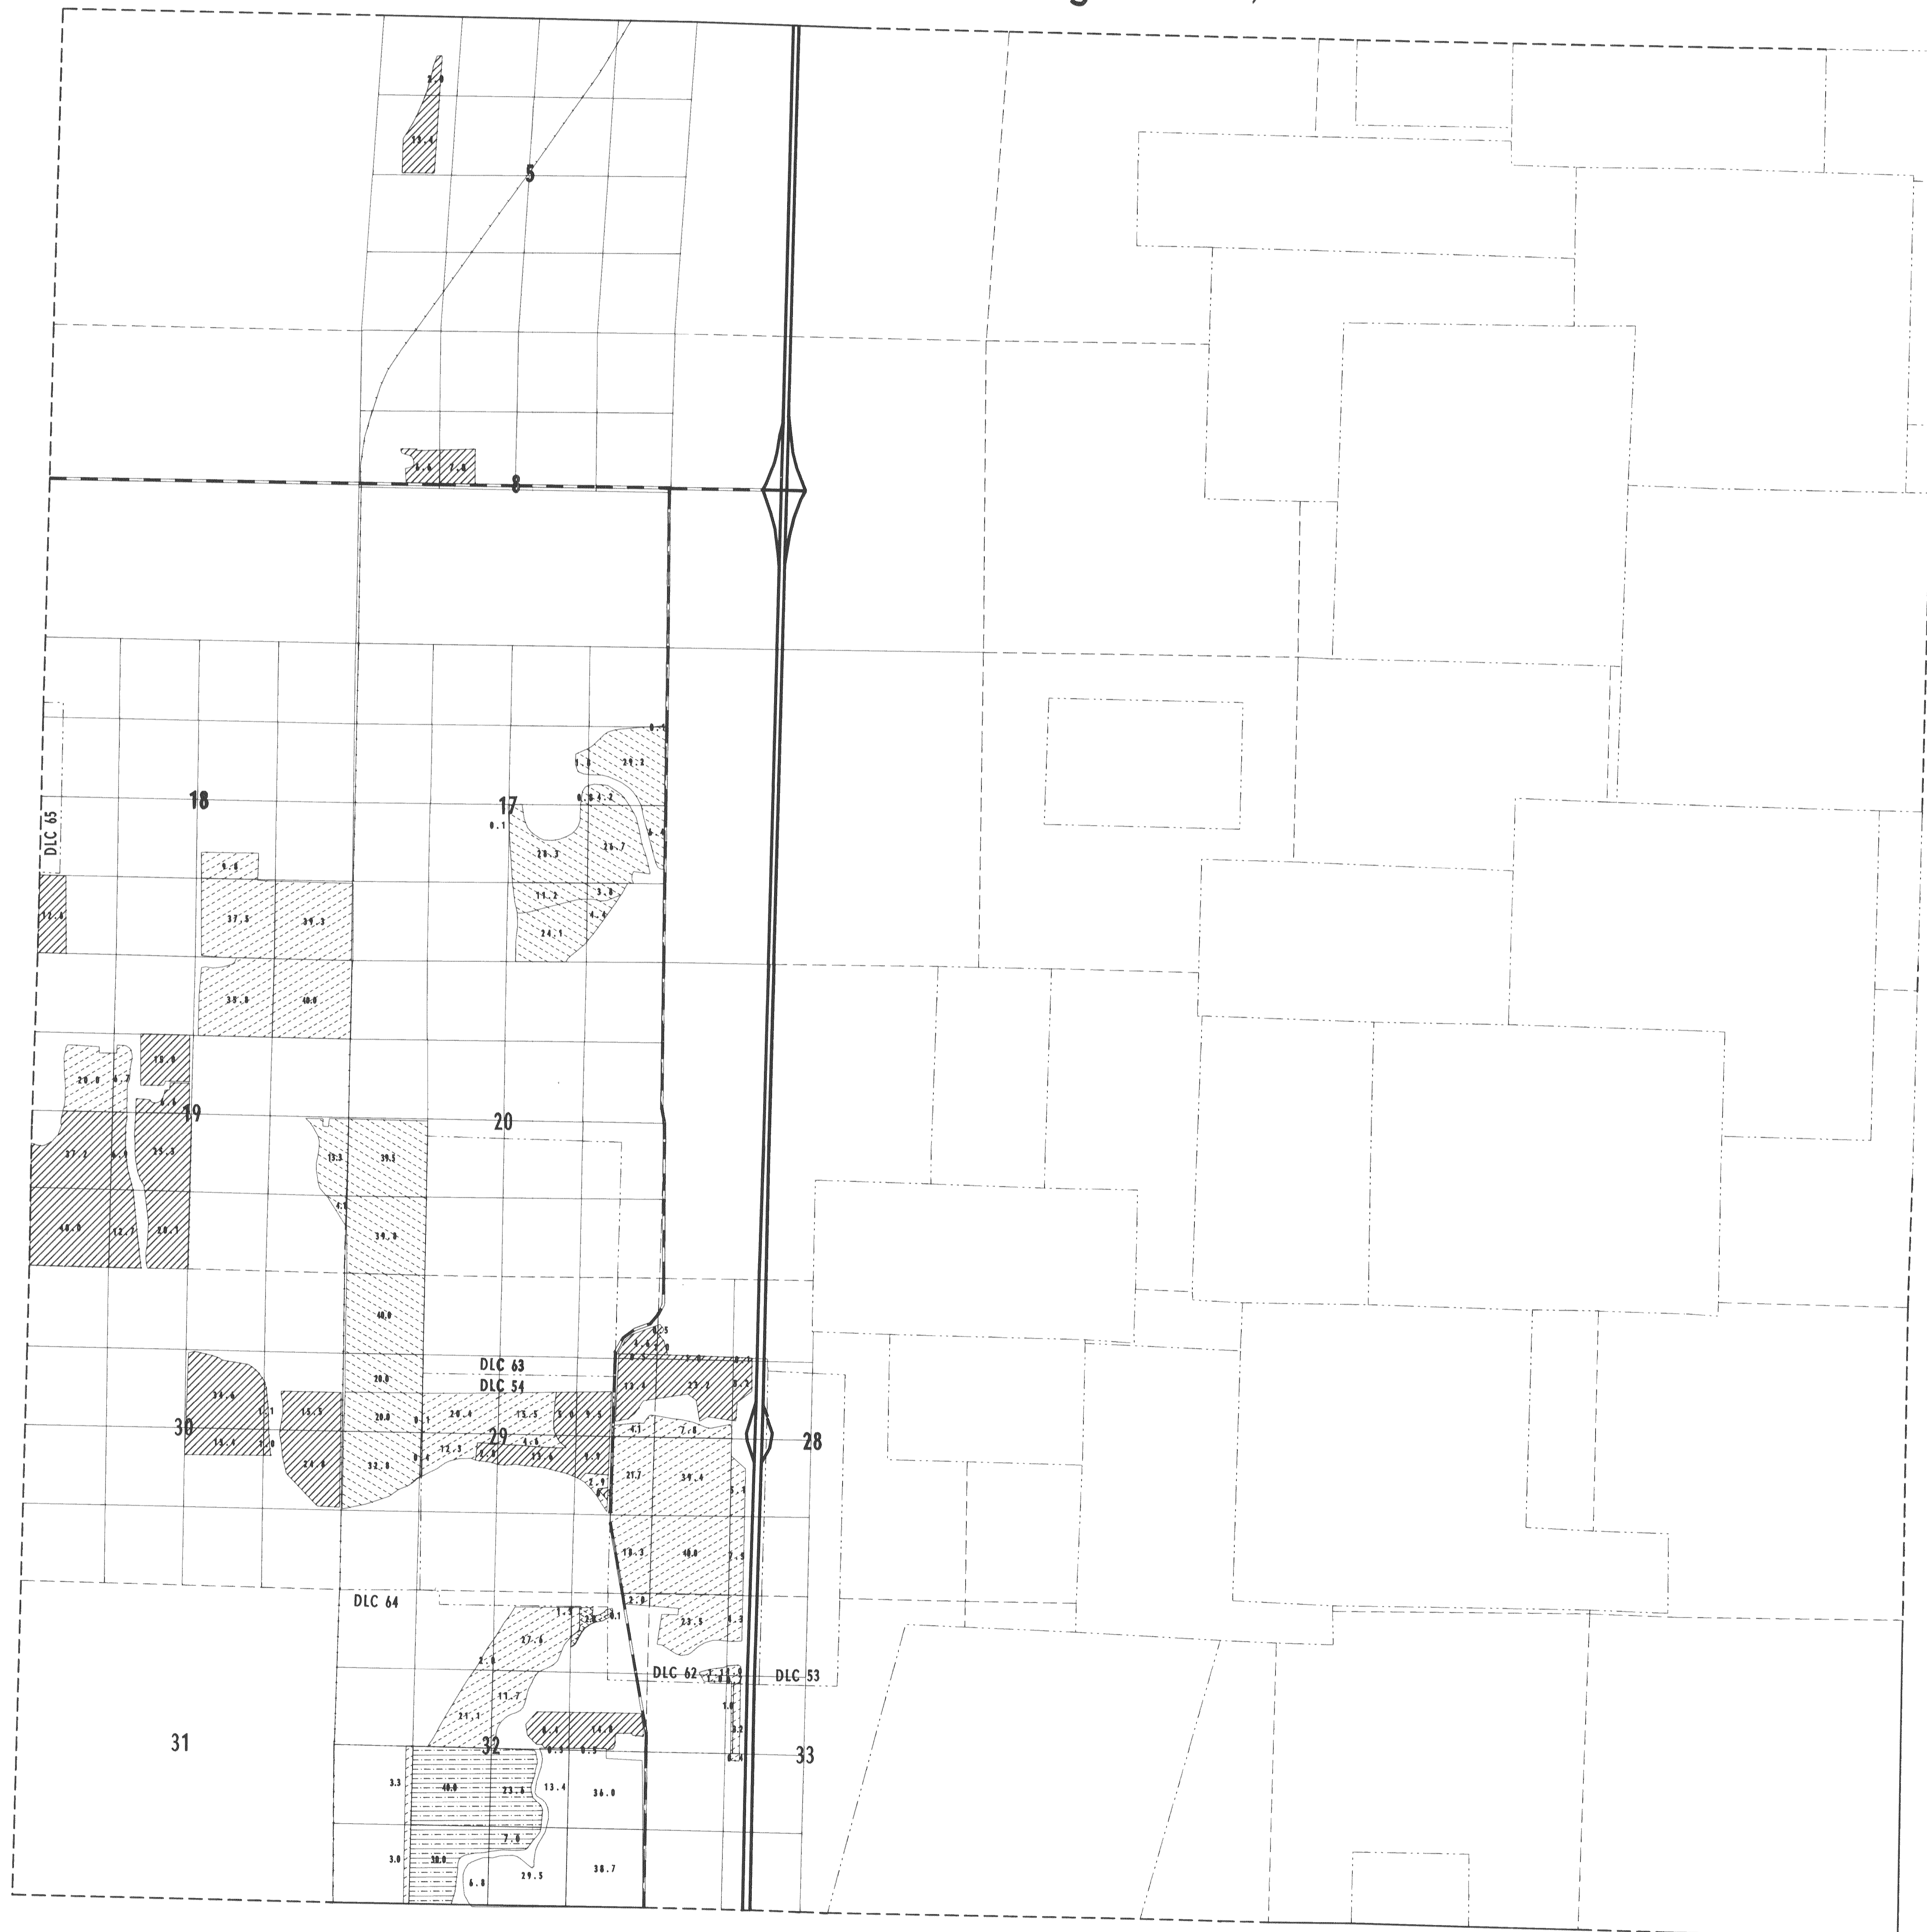

LEGEND

- Permit 50921
- Permit 37877
- Permit 42759
- Permit 43710
- Permit 45980
- Certificate 51589
- Certificate 62148
- Certificate 62201

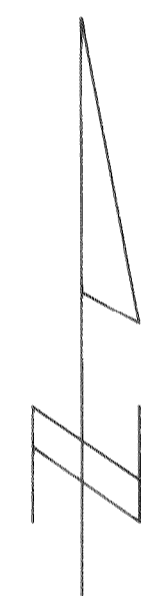

SCALE 1" = 1320'

FINAL PROOF SURVEY
UNDER

Application 49527	Permit 37877
55400	42759
57947	43710
58932	45980
68824	50921

IN NAME OF
MUDDY CREEKS IRRIGATION PROJECT

Surveyed 1993 By R.W.Klassen

User Name: rskl/1994 1:05 PM
Plot File: /arcdata/1/arc/1/arc/m/1533-1p