


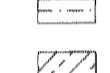
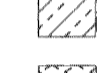

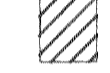



Twp. 15 S., Rng. 3 W., WM.

LEGEND

-  Permit 50921
-  Permit 37877
-  Permit 42759
-  Permit 43710
-  Permit 45980
-  Certificate 51589
-  Certificate 62148
-  Certificate 62201




SCALE 1" = 1320'

**FINAL PROOF SURVEY**  
UNDER

Application 49527	Permit 37877
55400	42759
57947	43710
58932	45980
68824	50921


IN NAME OF  
**MUDDY CREEKS IRRIGATION PROJECT**

Surveyed 1993 By R.W.Klassen

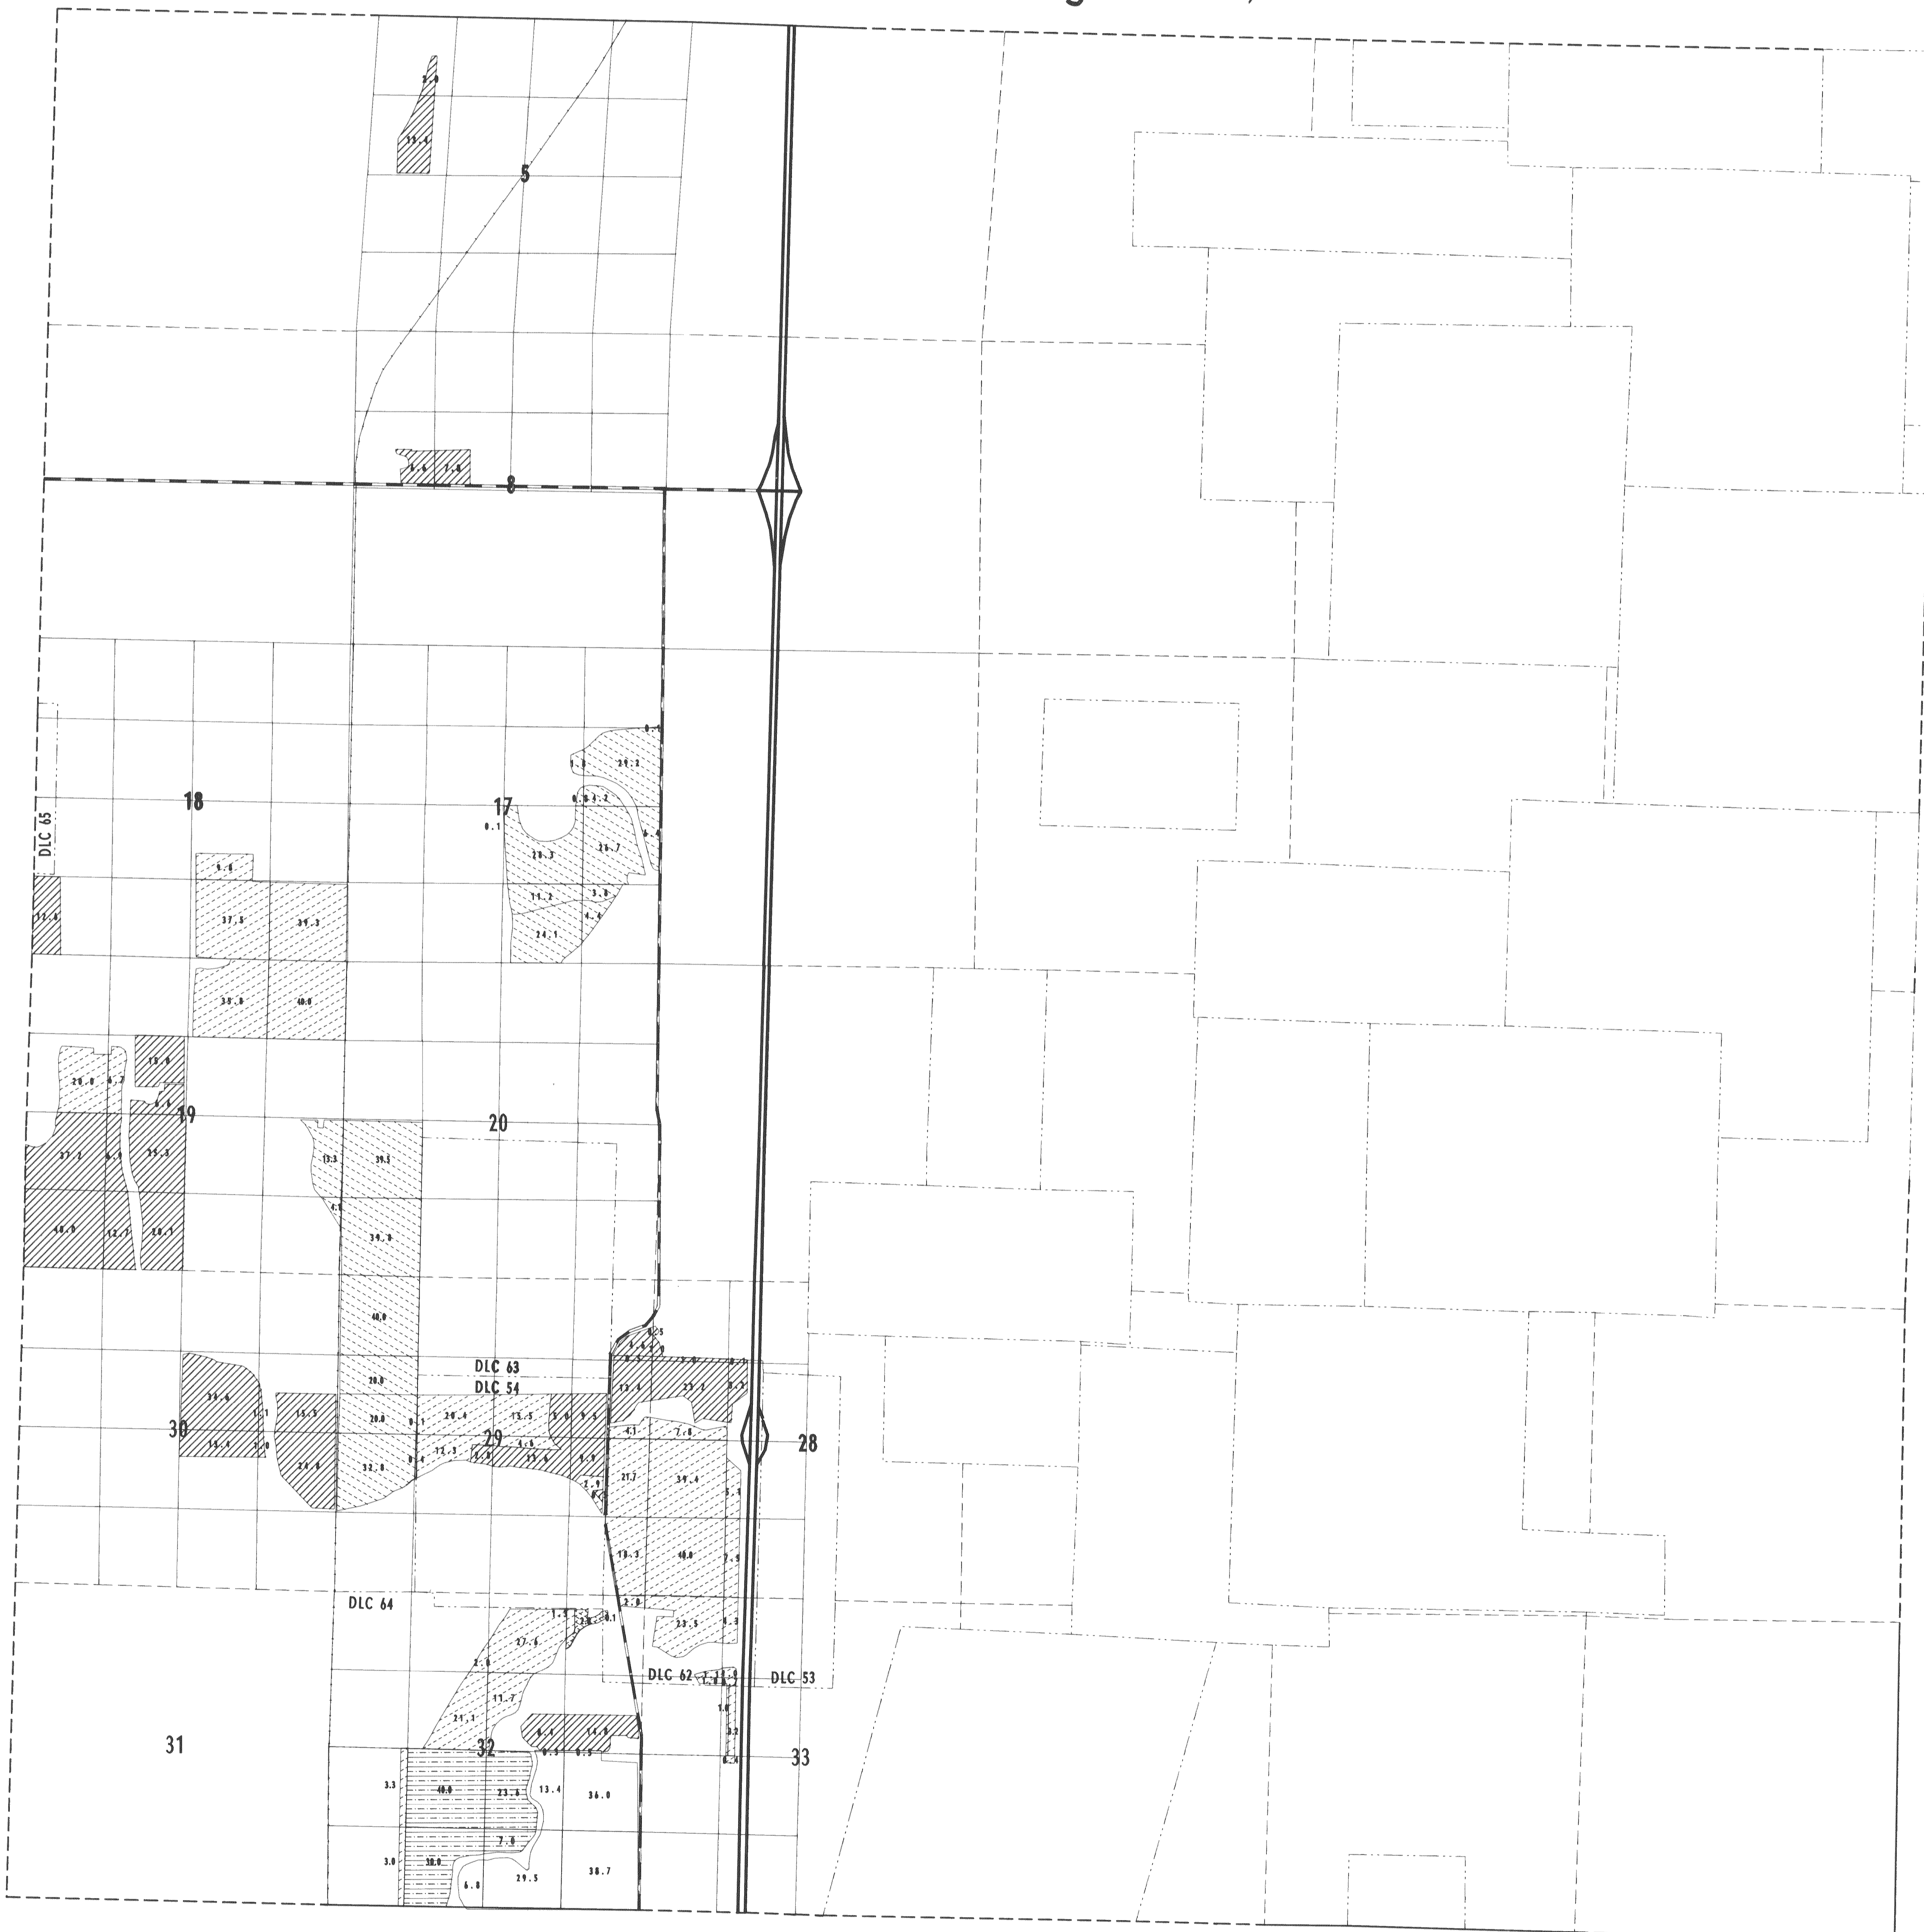
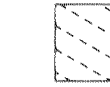

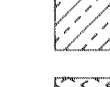




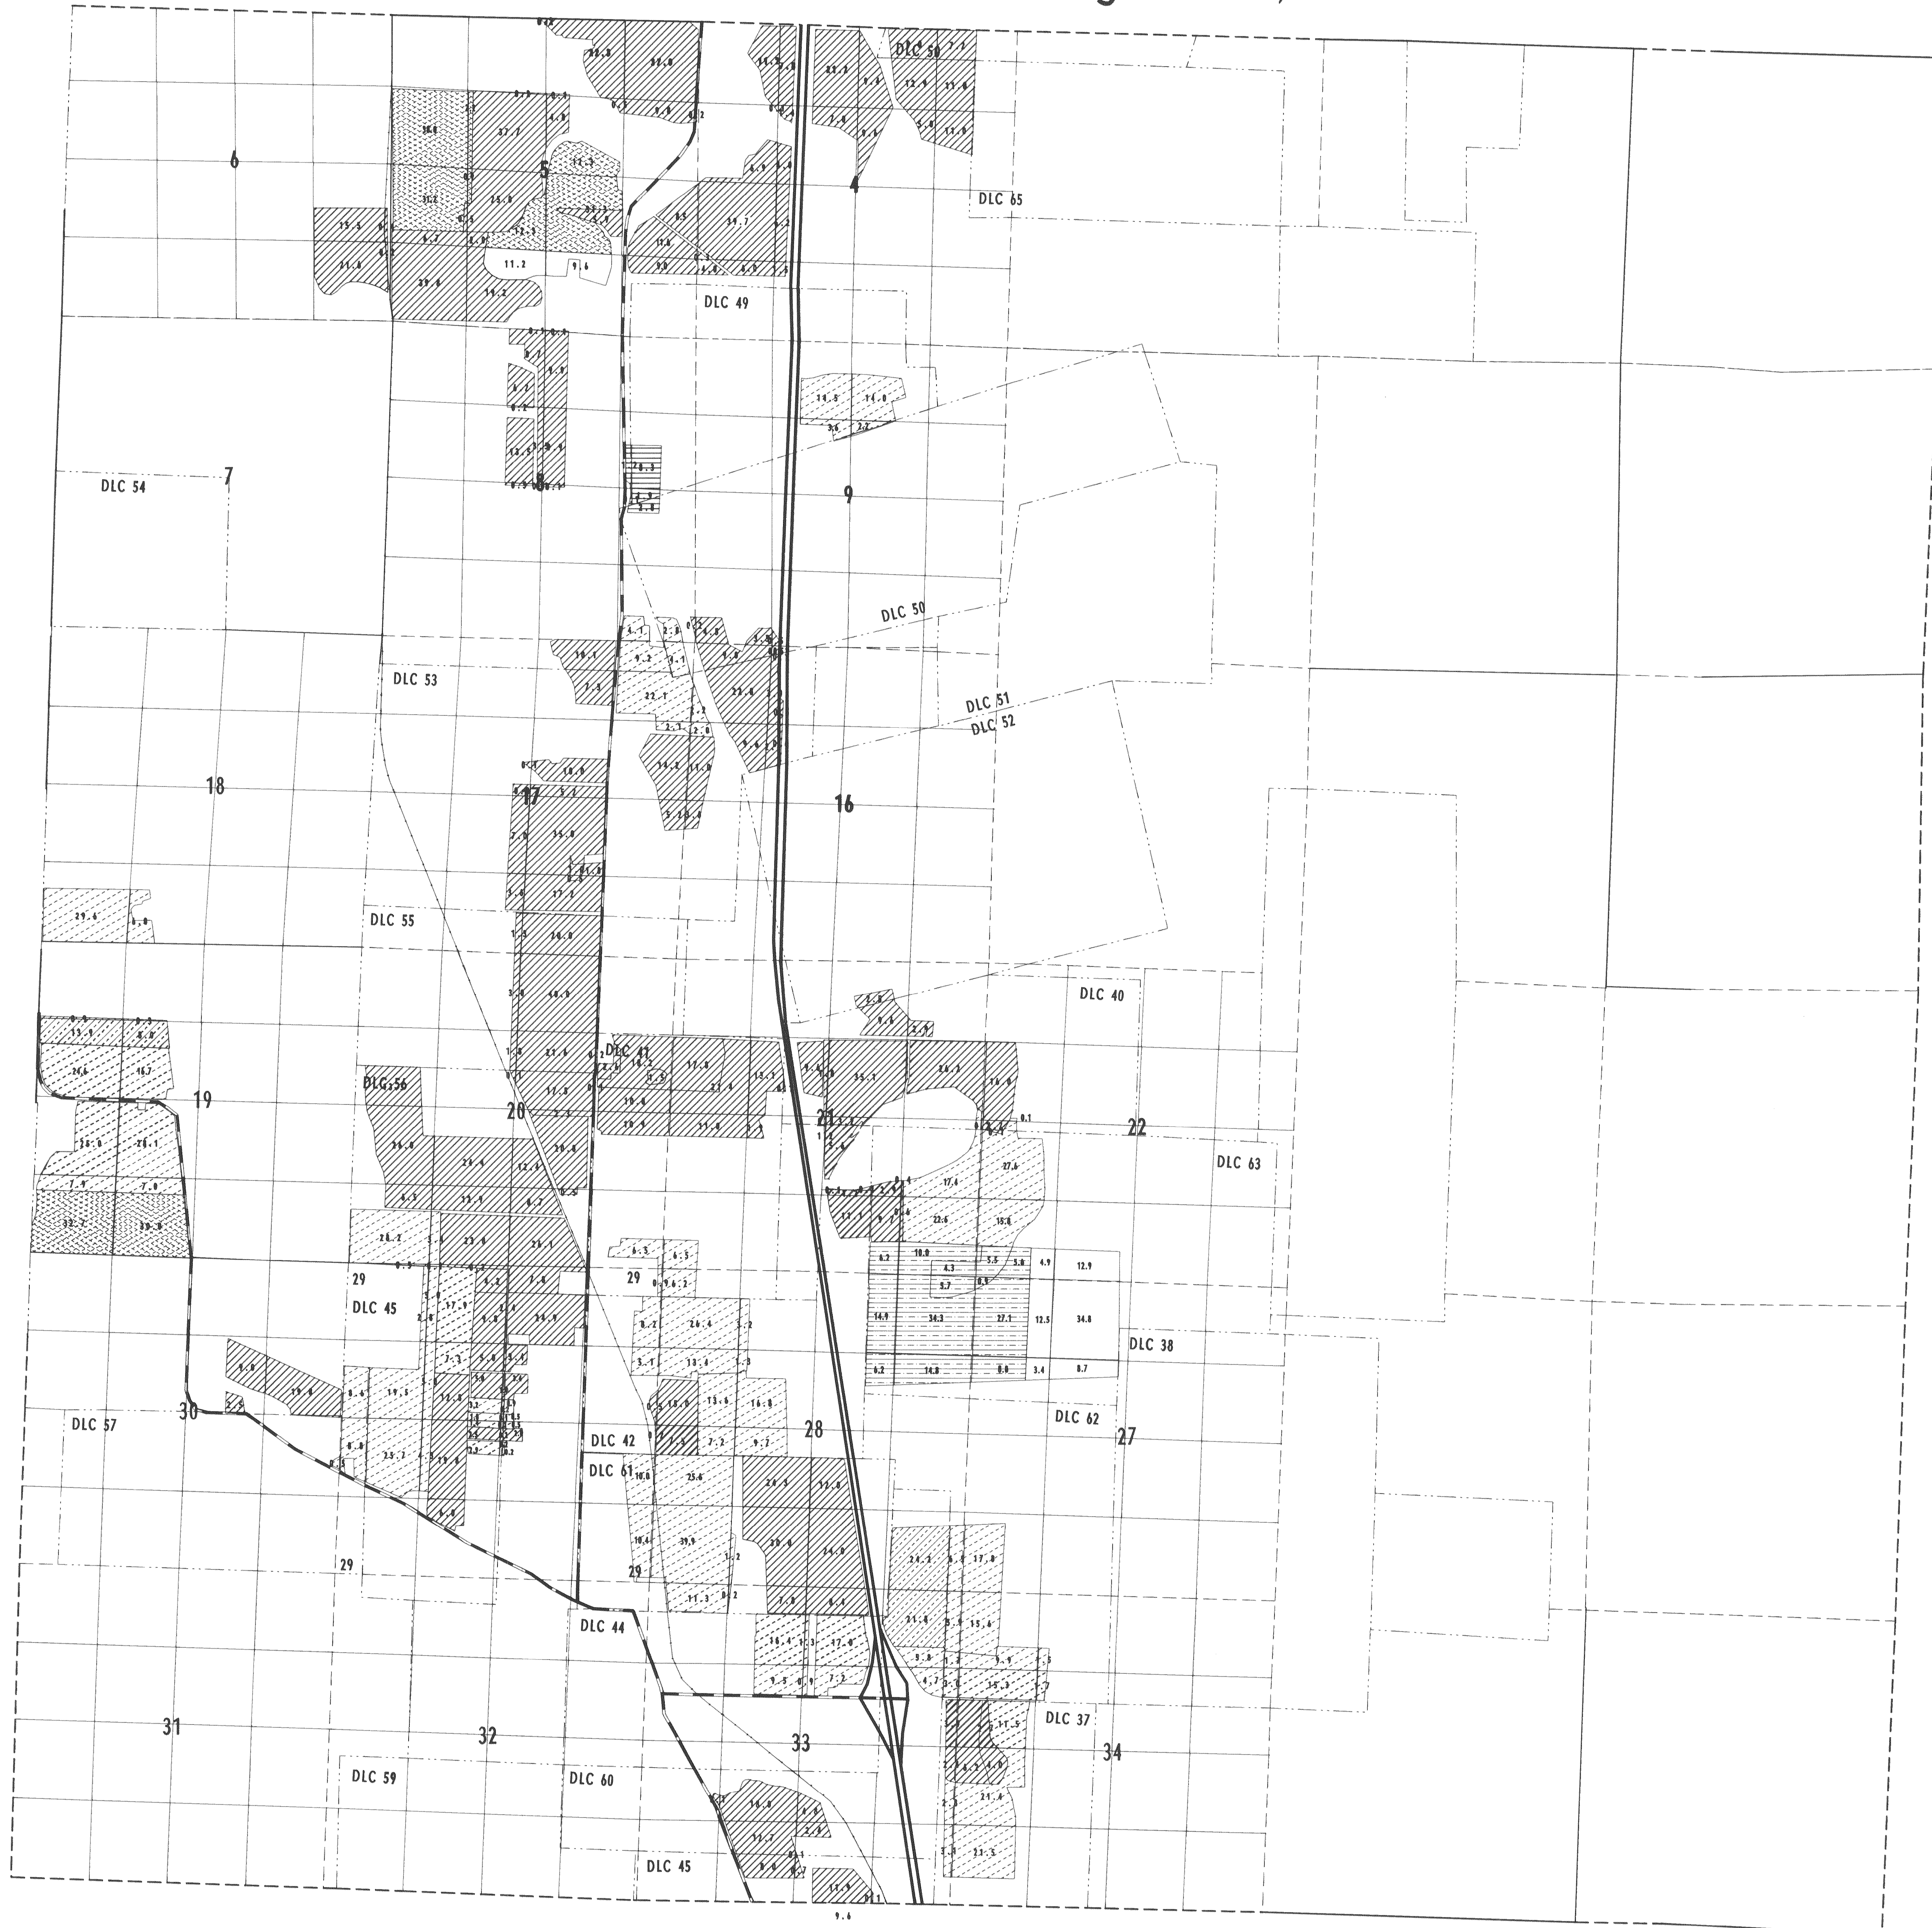

User name: rskate/1994 1:05 PM  
Plot file: /arcdata/1/arc/1/arc/m/1533-1p

# Twp. 16 S., Rng. 3 W., WM.



**LEGEND**

-  Permit 50921
-  Permit 37877
-  Permit 42759
-  Permit 43710
-  Permit 45980
-  Certificate 51599
-  Certificate 62148
-  Certificate 62281



SCALE 1" = 1320'

## FINAL PROOF SURVEY

UNDER

Application 49527	Permit 37877
55400	42759
57947	43710
58932	45980
68824	50921

IN NAME OF  
**MUDDY CREEKS IRRIGATION PROJECT**

Surveyed 1993 By R.W.Klassen