


**FINAL PROOF SURVEY
UNDER**

PERMIT NUMBER 51087
IN NAME OF
RICHARD AND MARIAN O'CONNELL

SURVEYED MARCH 16, 1992

BY

Gregory T. Blackman

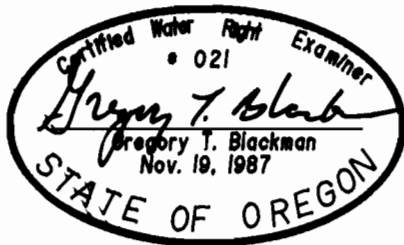

NOTE: The preparation of this map was for the purpose of identifying the location of the proposed water right and has no intent to provide dimensions or location of property ownership lines. Location information shown hereon was furnished by the applicant.