


T.4 S.R. I W.W.M.

RECEIVED

MAY 02 2005

WATER RESOURCES DEPT  
SALEM, OREGON

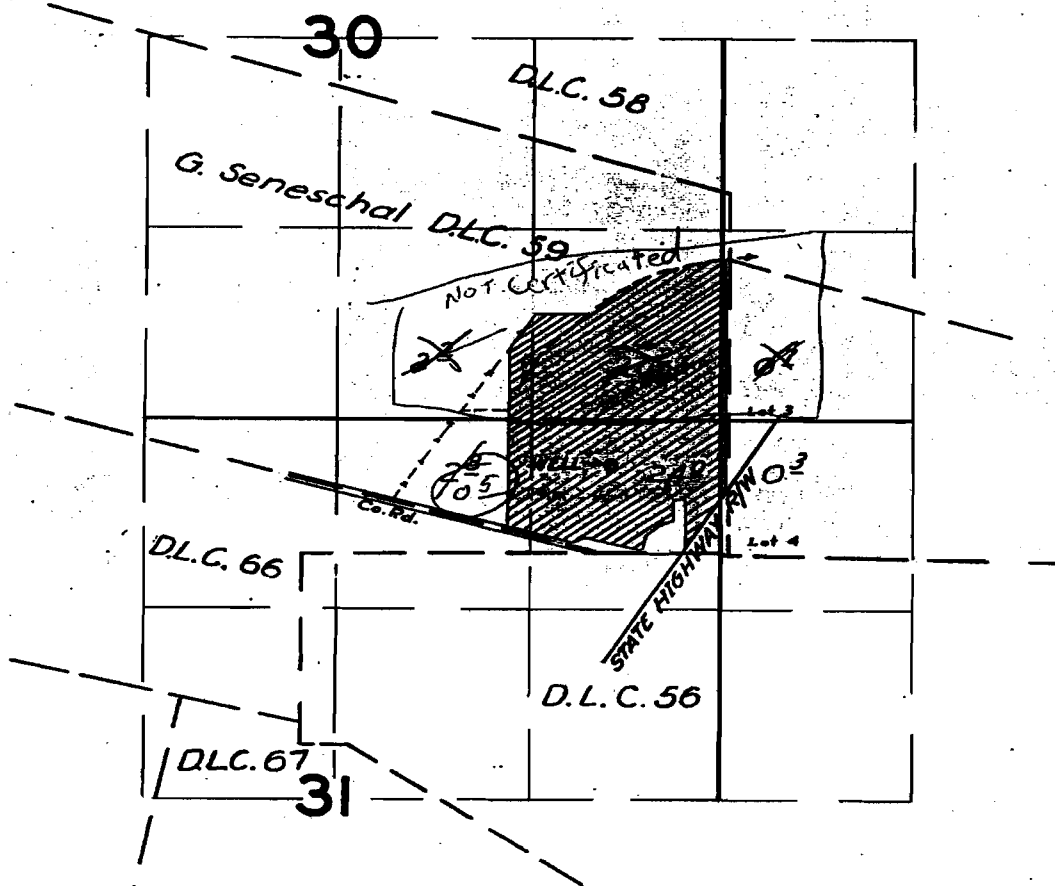

**FINAL PROOF SURVEY**  
UNDER

Application No. G-565 Permit No. G-460  
IN NAME OF

JESSE C. OWRE

Surveyed 20 Mar 1959 by M. B. Bish