


T.27S., R.7 W., W.M.

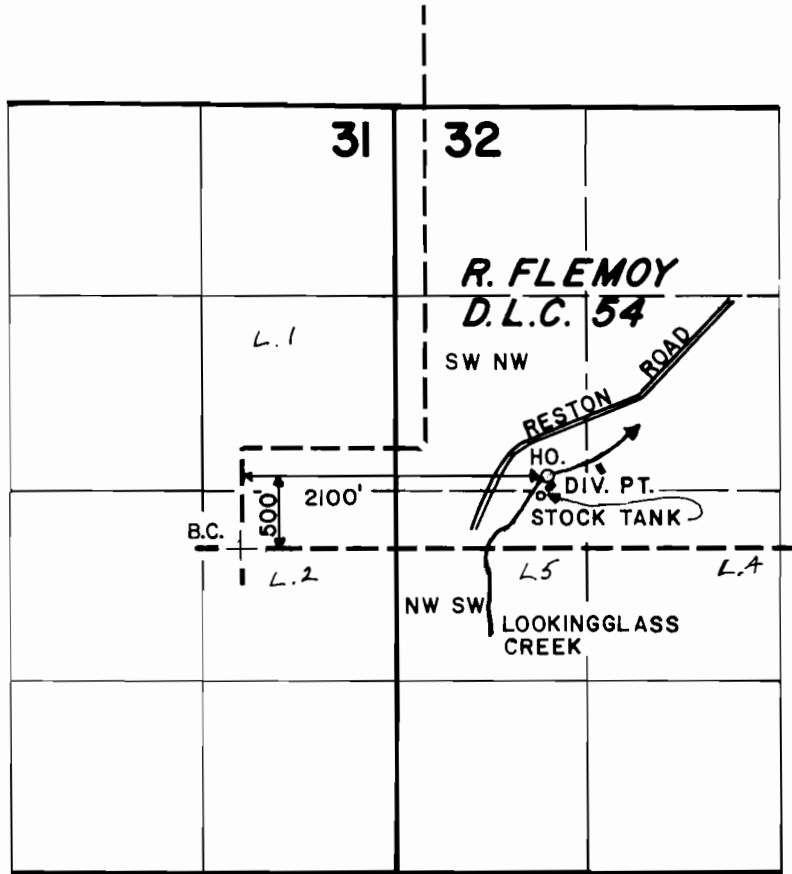

SCALE: 4" = 1 MILE

FINAL PROOF SURVEY
UNDER

Application No. 60402 Permit No. 45159
IN NAME OF

WILLIAM J. BLACK

Surveyed SEP. 4 1984, by L. E. CASHION