LB379

T 6333
&
T 6334
Vol 4 P68

T. 2N., R. 27E., W.M.

SCALE: 1" = 1320'

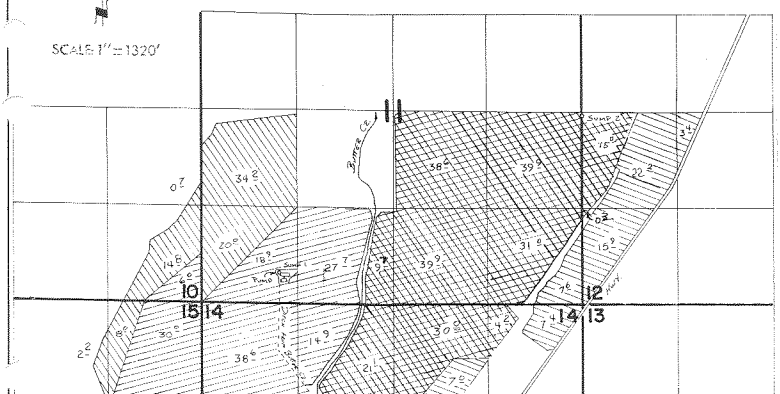

Sump 1 located 400'N. & 1150'E. from SW corner Section 11

Sump 2 located 2590'N. from SE corner Section 11

SCALE: 1" = 1320'

FINAL PROOF SURVEY

UNDER

G-5974 G-5663

PRIMARY SUPPLEMENTAL

Application No. G-10869 Permit No. G-10054

IN NAME OF

JERRY E. MYERS - MYERS FARM CO., INC.

Surveyed ..... 19.79.., by .....

11-18 1985 V. Chonski