


T.12S. R.6W.WM

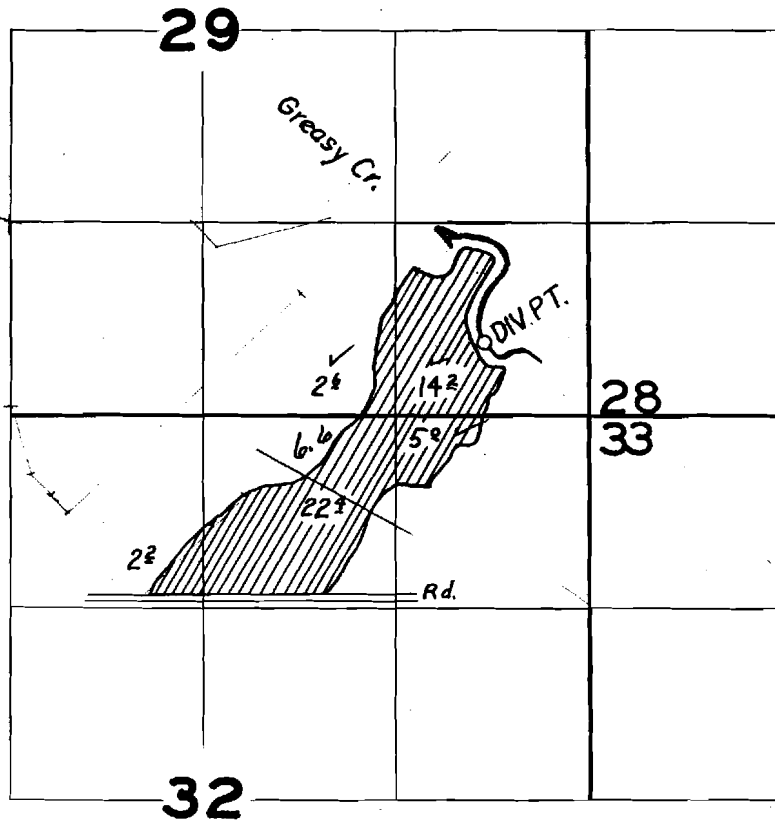

FINAL PROOF SURVEY
UNDER

Application No. 18680 Permit No. 14311

IN NAME OF

Ben and Mary Gooch

Surveyed Sept. 26 1953, by H.L. Coffman