


T10S. R4W. WM.

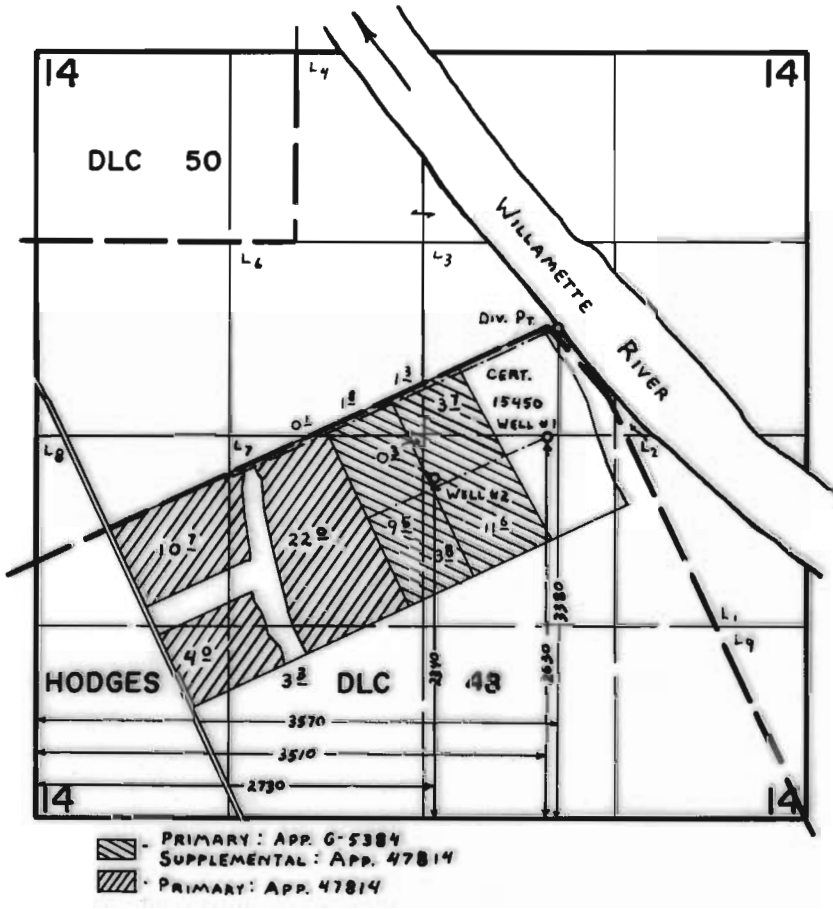

FINAL PROOF SURVEY UNDER

Application No. G-5384 47814 Permit No. G-5315 35846
 IN NAME OF
MRS. CLAUDE BUERGE
 Surveyed Sept. 6 1979, by C. L. HUGHES