



T. 9 S., R. 27 & 28 E. W.M.

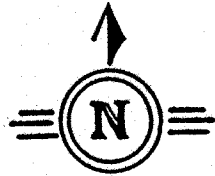

Scale 1" = 1320'

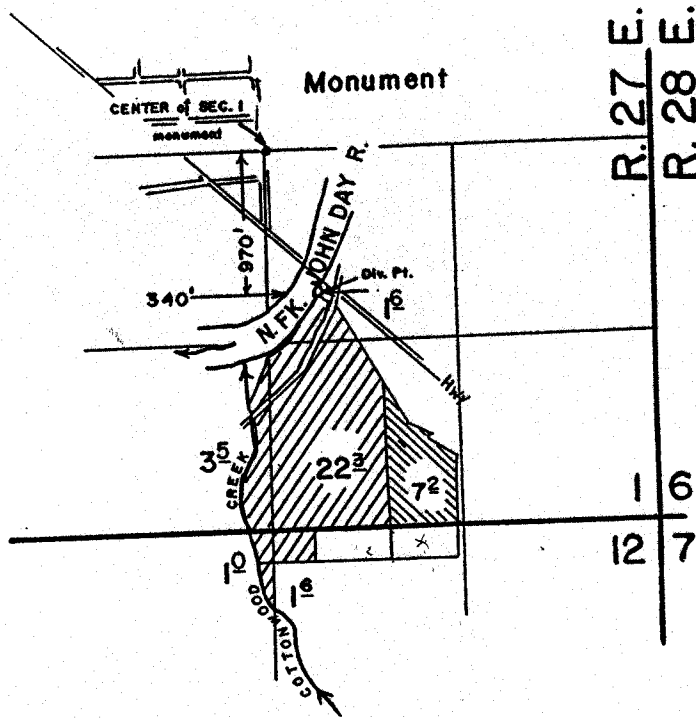

MURPHY

HUDSON

SUPERSEDING FINAL PROOF SURVEY MAP UNDER

Application No. 45622 Permit No. 34281.....
IN NAME OF

.....PHILIP MURPHY.....

Surveyed July 20 1971, by L.E. Gould.....