


T. 9 S. R. 27 & 28 E.

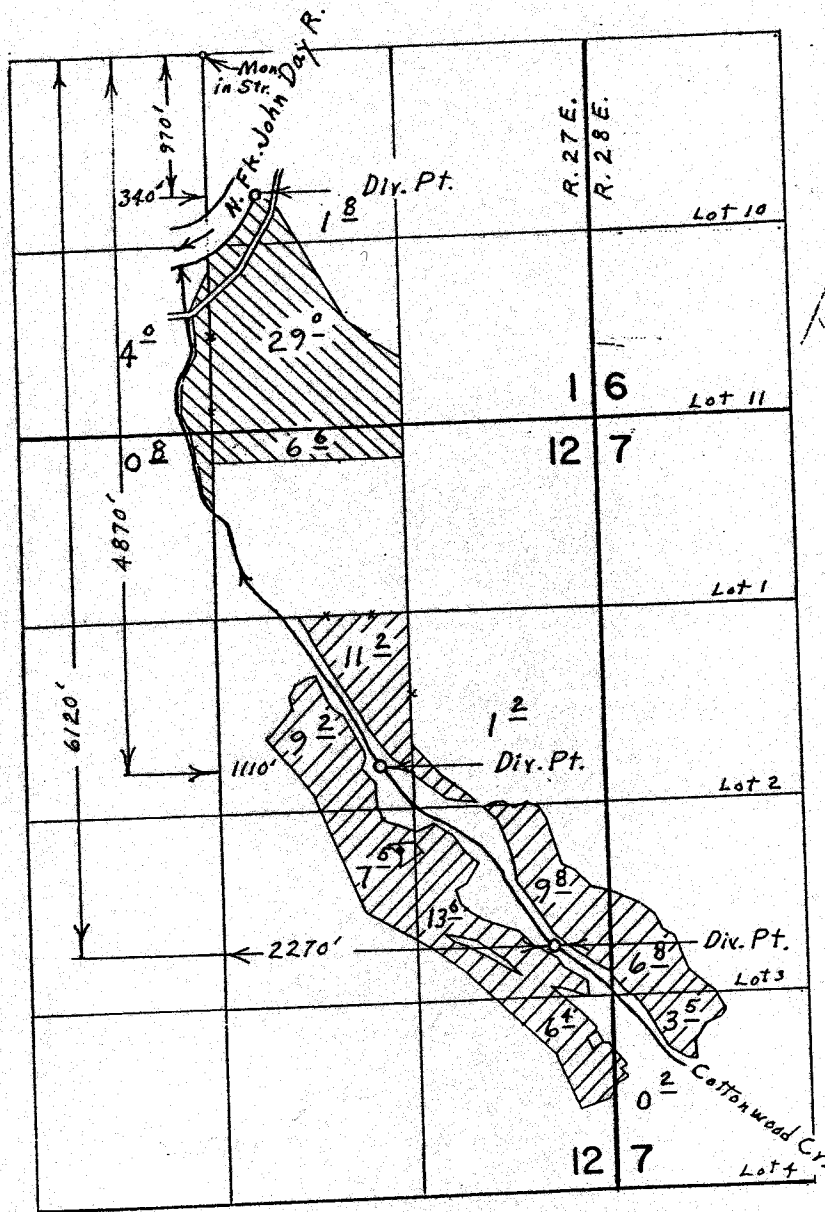

*Topography
Map
Dated 1971*

FINAL PROOF SURVEY

UNDER

N. Fk. John Day R.

Cottonwood Cr.

Transfer M-199

Transfer M-200

Application No. 45.622 Permit No. 34281

IN NAME OF

PHILIP MURPHY

Surveyed July 20, 1971, by L. E. Gould