


T.29S. R.4W. W.M.

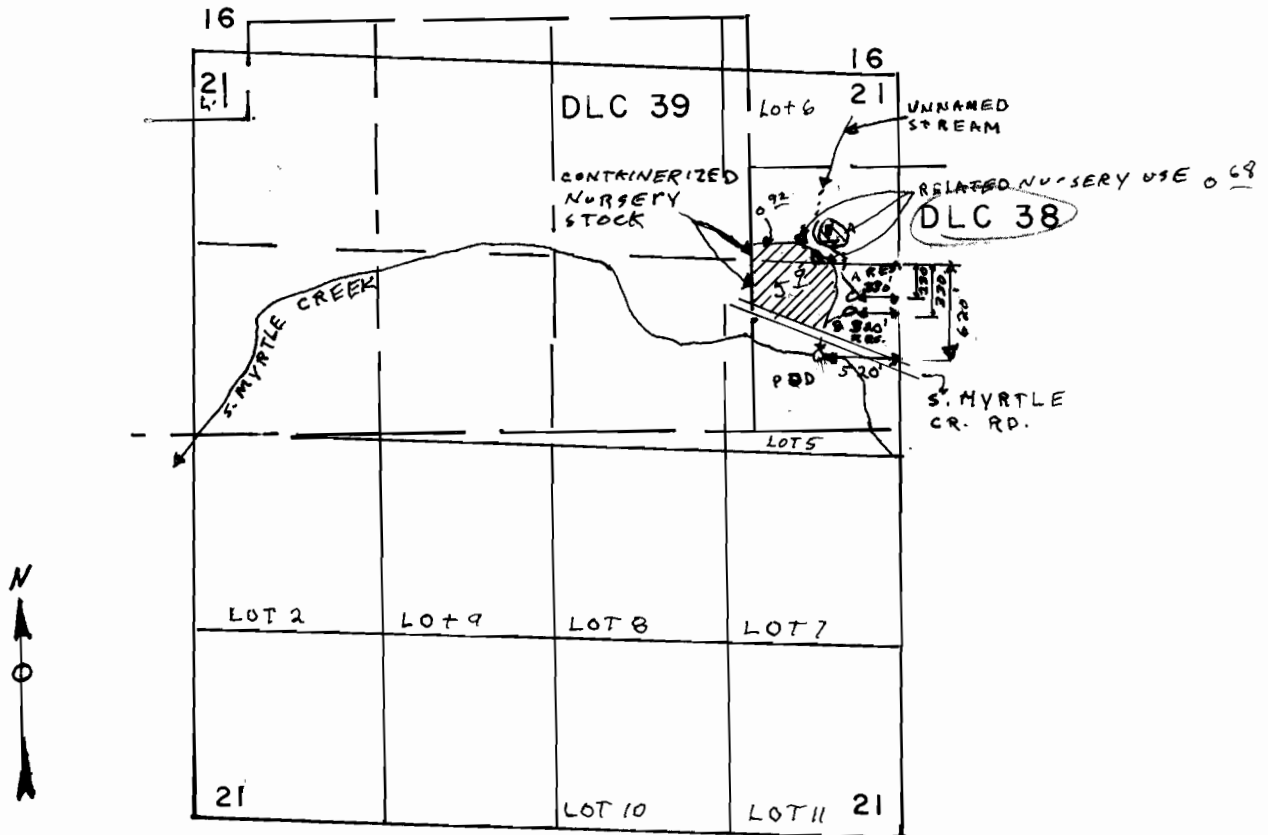

SCALE 1" = 1320'

FINAL PROOF SURVEY

THE PURPOSE OF THIS MAP IS TO IDENTIFY THE LOCATION OF THE WATER RIGHT. IT IS NOT INTENDED TO PROVIDE INFORMATION RELATIVE TO THE LOCATION OF PROPERTY OWNERSHIP BOUNDARY LINES.

UNDER

Application No. R69091 Permit No. R11230
69092 51016
IN NAME OF

WAYNE A. SNYDER

Surveyed SEPT. 8, 1991, by D. W. KIRBY.

