


G 8849

52633

68401

T7034

T.27S.,R.17E.,W.M.

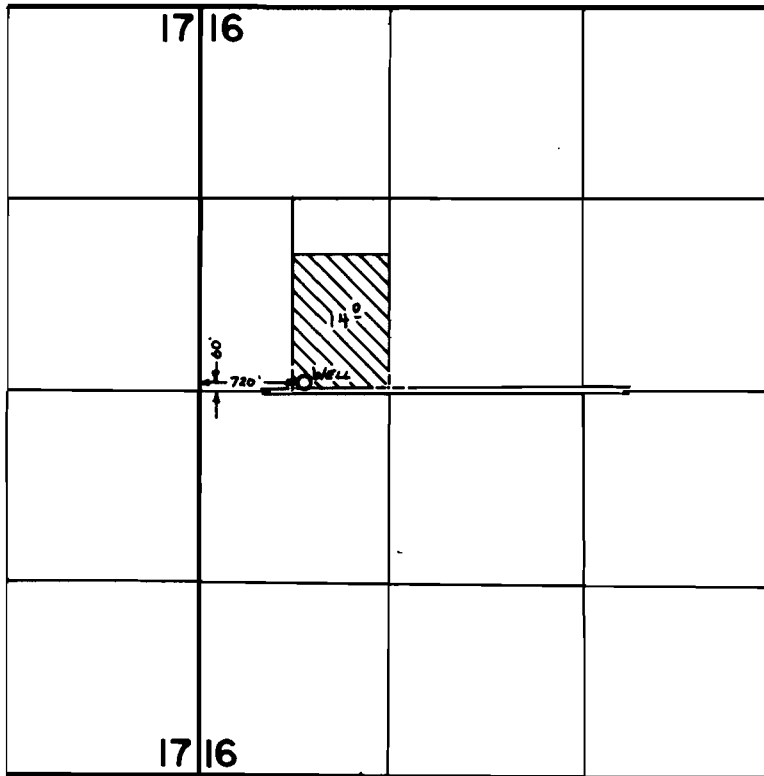

FINAL PROOF SURVEY
UNDER

Application No. .G:9576. Permit No. .G:8849.....
IN NAME OF

.....IRA NEUSCHWANDER.....

Surveyed .Oct..14.... 19.83., by .L..M..TOLL.....