


T. 3 S. R. 1 E. W. M.

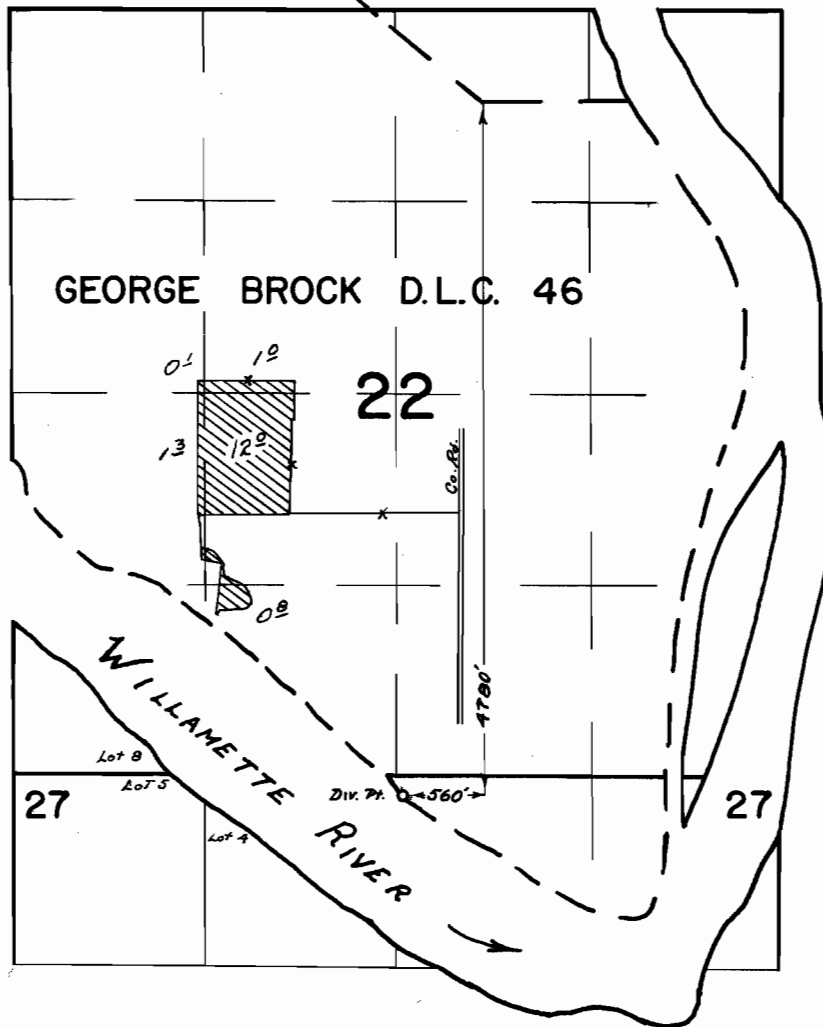

**FINAL PROOF SURVEY**  
UNDER

Application No. 48/77 Permit No. 35229  
IN NAME OF

ED. E. YOSHITOMI

Surveyed SEP. 11 1972, by P.G. MUCKEN