


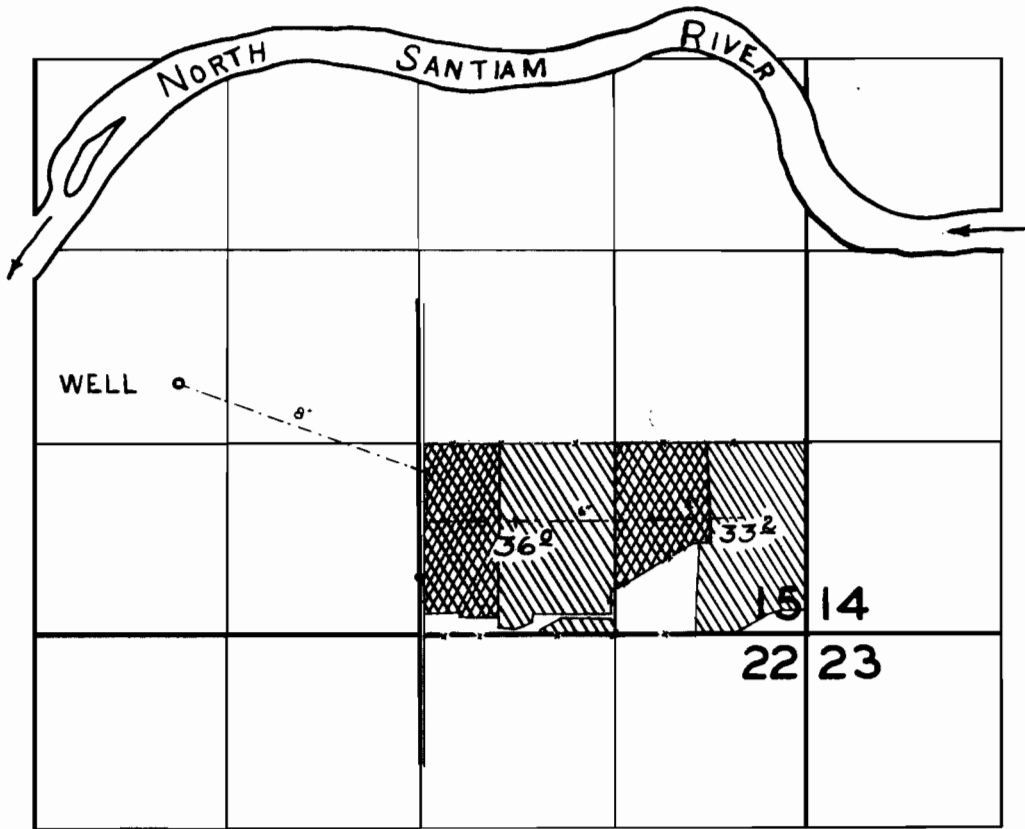

T. 9S. R. 1 W. W. M.



FINAL PROOF SURVEY UNDER

 PRIMARY SUPPLEMENTAL 

Application No. G-13,89. Permit No. G-12,55.
IN NAME OF

.....CARL BETHELL.....

Surveyed JULY 7, 1960, by M. BISH.....