
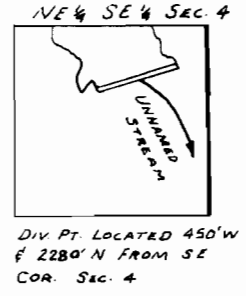


T.7S.R.5W.W.M.

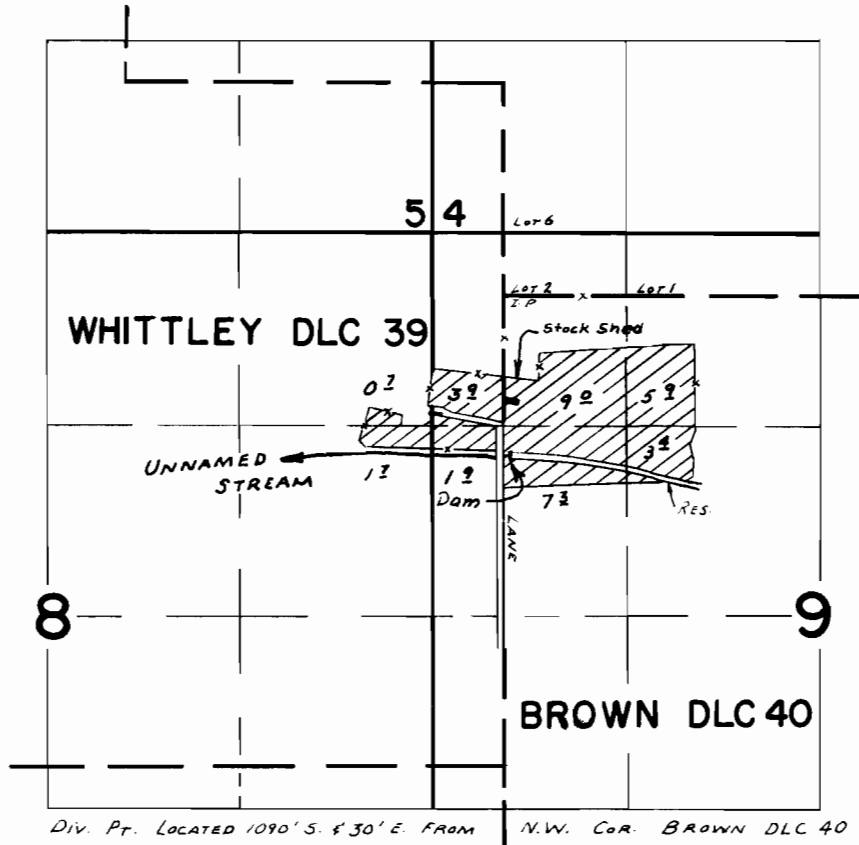

FINAL PROOF SURVEY UNDER

Application No. 41115 Permit No. 30803
IN NAME OF

CLARA HOEKSTRE

Surveyed APR. 21 1969, by D. BUELL