
T.7S., R.5W., W.M.

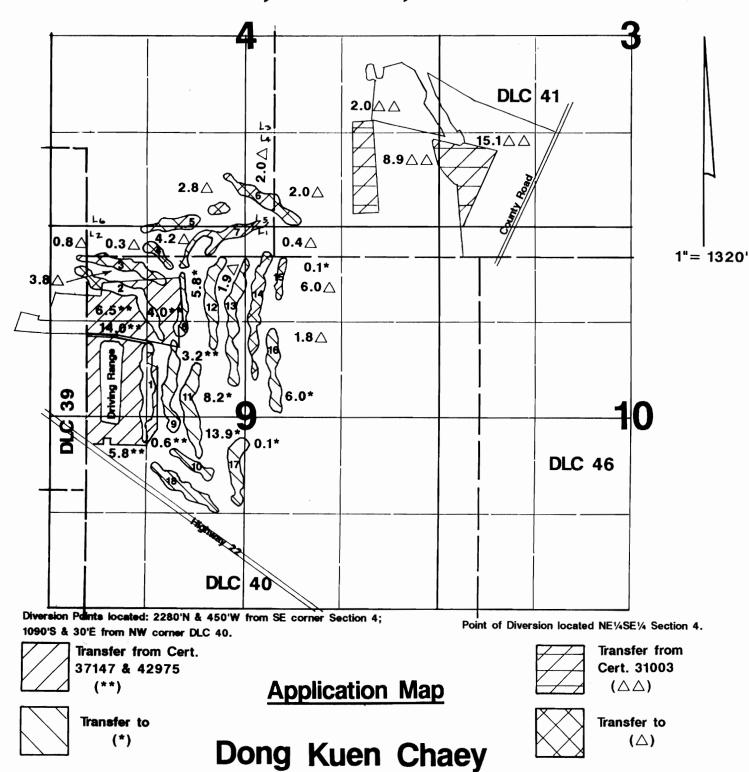

Application #:

Transfer #:


Gertified Water Right Examination #117

James M. Delinetto
Nov. 19, 1837

TE OF ORD GO

THIS MAP WAS PREPARED FOR THE PURPOSE OF IDENTIFYING THE LOCATION OF A WATER RIGHT ONLY AND IS NOT INTENDED TO PROVIDE LEGAL DIMENSIONS OR LOCATION OF PROPERTY OWNERSHIP LINES.

T.7S. R.5W.W.M.

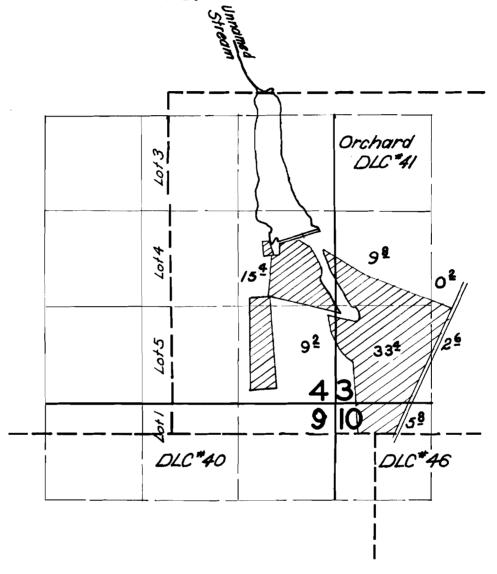

FINAL PROOF SURVEY

	<i>32373</i> 2374 NAME	<i>R-2147</i> Permit No. <i>25533</i> OF
William Reimer		
Surveyed WWV.5	1962	hy Carl R. Baker