
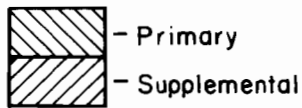


# T.6S.,R.1W.,W.M.

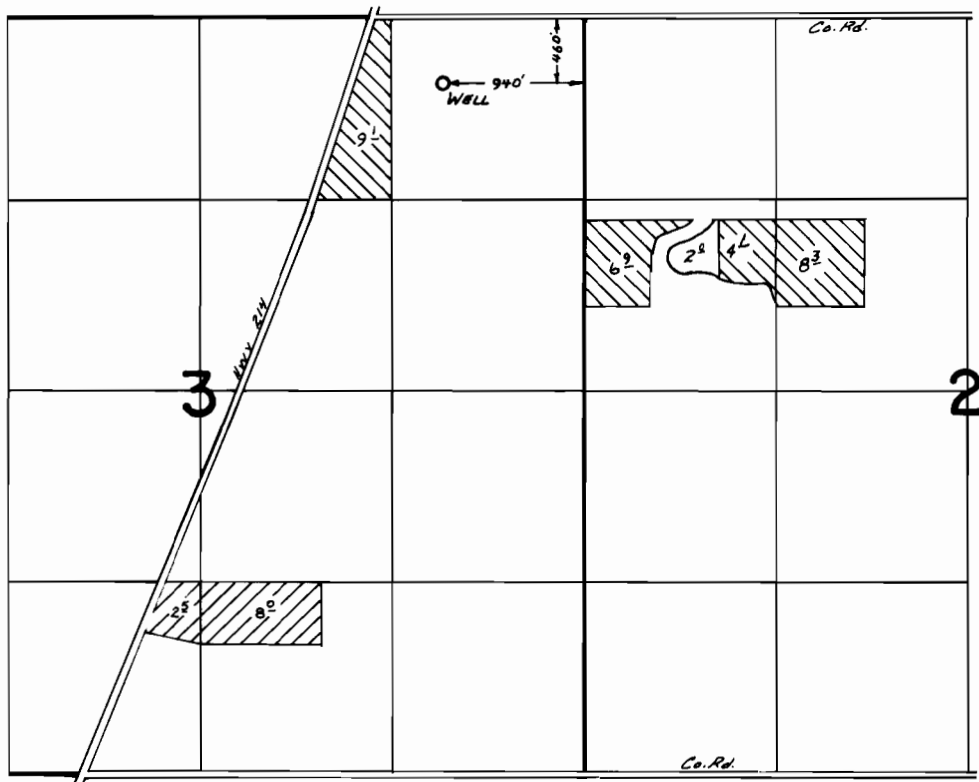

## FINAL PROOF SURVEY UNDER

Application No. .G:9732. Permit No. .G:8955....  
IN NAME OF

.....**HAROLD KRAEMER**.....

Surveyed Sept...9... 19.81., by .S..C..BROWN.....