T.6S., R.1E., W.M.

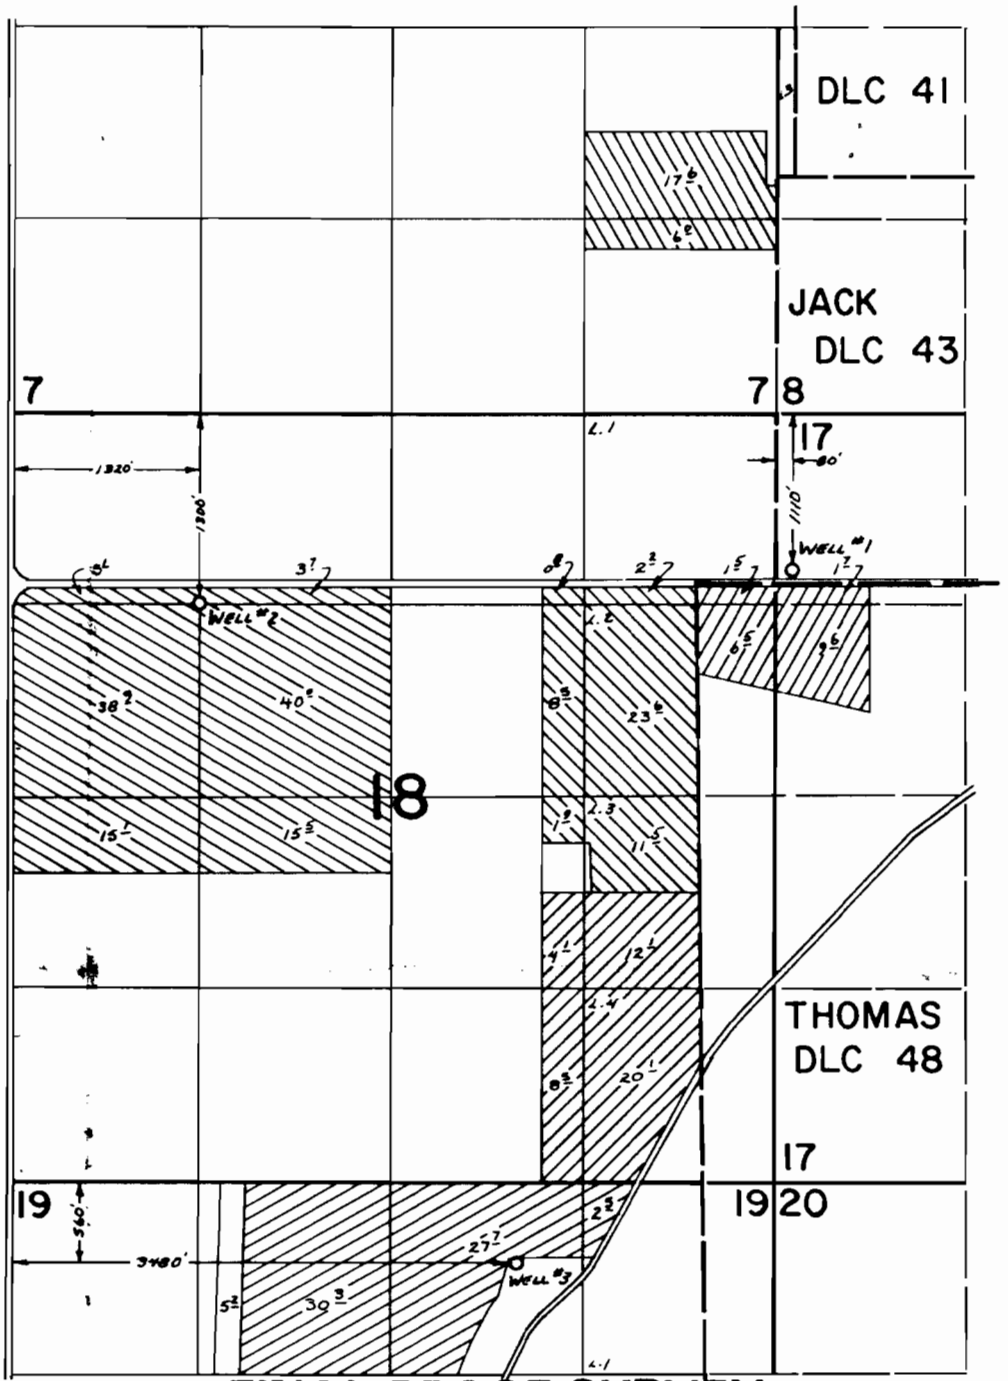

FINAL PROOF SURVEY

UNDER

G-8146 G-7584

G-9728 G-8952

G-9729 G-8953

Application No. G-9730 Permit No. G-9180

-From Well #1 -From Well #3

-Supplemental -Primary

IN NAME OF

HAROLD KRAEMER

Surveyed Sept. 9 19 81, by S. C. BROWN

DFN-4LL-56